

**MISSISSIPPI  
BOARD OF WATER COMMISSIONERS**  
416 North State Street  
Jackson, Mississippi 39201

**WATER WELL DRILLERS LOG CODED**

Marshall  
D 37  
6-11-75

6-11 1975 Dean Street Surface well Marshall  
date well completed firm name county well located

**LANDOWNER:**  
Silvester Stinson  
Holly Springs, Miss  
(mailing address)

description of formations encountered	from	to
<u>Clay</u>	<u>0</u>	<u>20</u>
<u>Sand</u>	<u>20</u>	<u>130</u>

**WELL LOCATION:**  
sec 26 T 4 N R 2 E 3 15E  
5 miles West of Holly Springs  
(distance) (direction) (nearest town)

**WELL PURPOSE:** Drinking  
(home, irrigation, municipal, industrial)

**WELL COMPLETION DATA:**

(1) diameter (inches) 4"

(2) total depth (feet) 130 feet

(3) static water level (feet) 90 feet below top of ground.

(4) casing PVC (material), 130 feet (depth)  
(size) if telescope see back.

(5) screen 8 feet (length), 122 feet (depth to top)  
4" (size), Gravel Wash (material)

(6) pump 3/4 (HP), 14 (yield gpm)  
(type power)

(7) electric log Elect. (yes or no)  
(organization running log)

(8) how well bottom plugged 4" log

**DRILLERS REMARKS:**


**CODED**

**DEC 11 1975**

**MISS. Bd. Of**

If well telescopes please sketch and show depths.

GROUND LEVEL

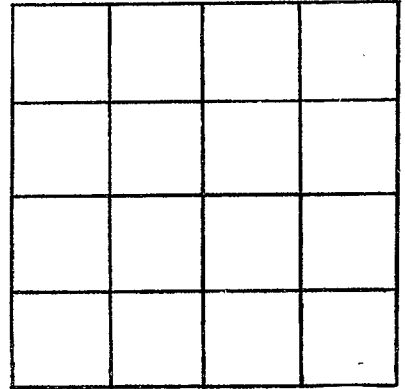

SECTION \_\_\_\_\_

Please indicate well location X.

ADDITIONAL INFORMATION

If more than one screen,  
show locations of each on sketch.