

MISSISSIPPI DEPARTMENT OF NATURAL RESOURCES

Bureau of Land and Water Resources

Southport Mall

P.O. Box 10631

Jackson, Mississippi 39209

WATER WELL DRILLERS LOG

CODED

Marshall
 38
 8-26-81

8-26 1981 Pennington Pump Marshall
 date well completed firm name county well located

LANDOWNER:	description of formations encountered	from	to
St. Mark Church	clay	0	20
Holly Springs miss (mailing address)	sand	20	90
WELL LOCATION:	clay	90	95
SE 1/4 SW 1/4 sec. 3 T 4 N R 3 E	sand	95	190
5 miles S.W. of Holly Springs (distance) (direction) (nearest town)	clay	190	195
WELL PURPOSE: Drilling (home, irrigation, municipal, industrial)	sand	195	210
WELL COMPLETION DATA:			
(1) diameter (inches) 4"			
(2) total depth (feet) 210 feet			
(3) static water level (feet) 155 below top of ground.			
(4) casing PVC, 210 feet (material) (depth)			
(size) if telescope see back.			
(5) screen 7ft, 203 (length) (depth to top)			
4" gravel well (size) (material)			
(6) pump 3/4 HP, 14 (HP) (yield gpm)			
(type power)			
(7) electric log Det. (yes or no)			
(organization running log)			
(8) how well bottom plugged 4" cap			
DRILLERS REMARKS:			

CODED


DEPT. OF NATURAL RESOURCES
 BUREAU OF LAND & WATER RESOURCES

NOV 16 1981

RECEIVED

If well telescopes please
sketch and show depths.

GROUND LEVEL

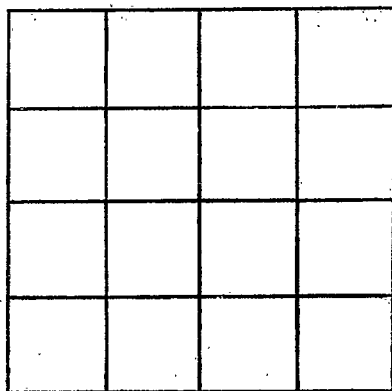

SECTION _____

Please indicate well location X.

ADDITIONAL INFORMATION

If more than one screen,
show locations of each on sketch.