

MARSHALL

2000

10-17-75

MISSISSIPPI BOARD OF WATER COMMISSIONERS

416 North State Street
Jackson, Mississippi 39201

WATER WELL DRILLERS LOG

Oct 17 1975
date well completed

R. L. Carpenter
firm name

Marshall
county well located

LANDOWNER: Dennis Clifton
Holly Springs
Miss. RFD
(mailing address)


description of formations encountered	from	to
surface soil	0	22
red. Red sand	22	35
med. white sand	35	90
white clay & white fine sand	90	125
med. white sand	125	190
white fine sand	190	210
white coarse sand	210	240

WELL LOCATION:
sec. 24 T 4 N R 3 E
S W
2 miles South of Holly Springs
(distance) (direction) (nearest town)

WELL PURPOSE: Home
(home, irrigation, municipal, industrial)

WELL COMPLETION DATA:

- (1) diameter (inches) 4
- (2) total depth (feet) 240
- (3) static water level (feet) 160 below top of ground.
- (4) casing Plastic 234 ft. (material) (depth)
if telescope see back.
- (5) screen 6 ft. 234 ft. (length) (depth to top)
4 in. Plastic + steel (size) (material)
- (6) pump 3/4 10 (HP) (yield gpm)
Elec. (type power)
- (7) electric log No. (yes or no)
- (8) how well bottom plugged Plastic cap (organization running log)

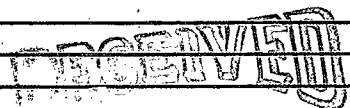

MAR 2 1976

MISS. BD. OF WATER COMMISSIONERS

DRILLERS REMARKS:

If well telescopes please sketch and show depths.

GROUND LEVEL

2

		X	

SECTION 24

Please indicate well location X.

ADDITIONAL INFORMATION

If more than one screen, show locations of each on sketch.