

MARSHALL
 0 2002
 1-6-76

MISSISSIPPI
 BOARD OF WATER COMMISSIONERS
 416 North State Street
 Jackson, Mississippi 39201

WATER WELL DRILLERS LOG

Jan. 6 1976 R. L. Carpenter Marshall
 date well completed firm name county well located

LANDOWNER: Henry Bell Jr.
Holly Springs, Miss
RFD
 (mailing address)

description of formations encountered	from	to
Surface Soil	0	20
med Red sand	20	38
med coarse white sand	38	100
white clay	100	115
white fine sand	115	200
white coarse sand	200	225

WELL LOCATION:
 sec. 24 T-14 N R-3 E
2 miles South of Holly Springs
 (distance) (direction) (nearest town)

WELL PURPOSE: Home
 (home, irrigation, municipal, industrial)

- WELL COMPLETION DATA:
- (1) diameter (inches) 4
 - (2) total depth (feet) 225
 - (3) static water level (feet) 148 below top of ground.
 - (4) casing Plastic, 219 Ft.
 (material) (depth)
 (size) if telescope see back.
 - (5) screen 6 Ft., 219 Ft.
 (length) (depth to top)
1/2 in. Plastic & Drivul
 (size) (material)
 - (6) pump 3/4 10
 (HP) (yield gpm)
Electric
 (type power)
 - (7) electric log no
 (yes or no)
 - (organization running log)
 - (8) how well bottom plugged Plastic Cap


DRILLERS REMARKS:

RECEIVED
 FEB 10 1977

MISS. BD. OF WATER COMM.

If well telescopes please
sketch and show depths.

GROUND LEVEL

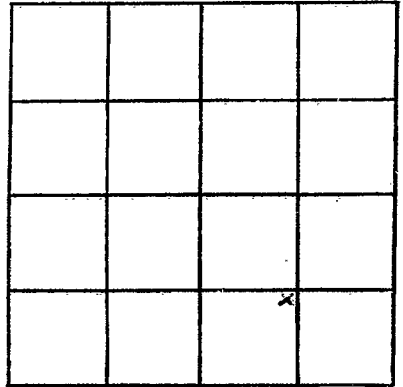

SECTION 24

Please indicate well location X.

ADDITIONAL INFORMATION

If more than one screen,
show locations of each on sketch.