

MARSHALL

0003

2/26/76

MISSISSIPPI BOARD OF WATER COMMISSIONERS  
416 North State Street  
Jackson, Mississippi 39201

WATER WELL DRILLERS LOG

Feb 26  
date well completed

1976 Billy R. Simpson  
firm name

MARSHALL  
county well located

LANDOWNER:  
DENNIS BARRENTINE  
MEMPHAS TENN  
(mailing address)

description of formations encountered	from	to
SURFACE CLAY	0	16
SAND & CLAY	16	33
WHITE CLAY	33	39
FINE SAND	39	130
COARSE SAND	130	170


WELL LOCATION:  
sec. 9 T 4 R 3  
4 miles W of Holly Spgs.  
(distance) (direction) (nearest town)

WELL PURPOSE: HOME  
(home, irrigation, municipal, industrial)

- WELL COMPLETION DATA:
- (1) diameter (inches) 4
  - (2) total depth (feet) 170
  - (3) static water level (feet) 98 below top of ground.
  - (4) casing POC 164 (material) (depth)
  - (size) if telescope see back.
  - (5) screen 6" 164 (length) (depth to top)
  - 4" POC (size) (material)
  - (6) pump 3/4 10 (HP) (yield gpm)
  - Elec (type power)
  - (7) electric log No (yes or no)

(organization running log)  
(8) how well bottom plugged POC CAP


DRILLERS REMARKS:

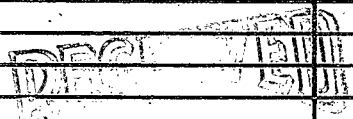

APR 29 1976

If well telescopes please sketch and show depths.

GROUND LEVEL

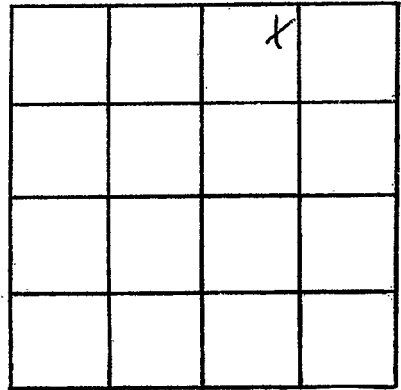

SECTION 9

Please indicate well location X.

ADDITIONAL INFORMATION

If more than one screen,  
show locations of each on sketch.