

Marshall  
 \$ 2005  
 7-1-76

MISSISSIPPI  
 BOARD OF WATER COMMISSIONERS  
 416 North State Street  
 Jackson, Mississippi 39201

WATER WELL DRILLERS LOG

7-1 1976 <sup>15E</sup> Hicks Well Co. Marshall  
 date well completed firm name county well located

LANDOWNER: <u>Jannie Patton</u>	description of formations encountered	from	to
<u>Pt. 3</u>			
<u>Holly Springs, Miss</u> (mailing address)	<u>Red K + Clay</u>	<u>0</u>	<u>10</u>
	<u>White clay</u>	<u>10</u>	<u>65</u>
	<u>White Sand + clay</u>	<u>65</u>	<u>170</u>
	<u>White Sand</u>	<u>170</u>	<u>220</u>

WELL LOCATION:  
 sec. 2 T 4 N R 3 E  
S W  
2 miles W of Holly Springs  
 (distance) (direction) (nearest town)

WELL PURPOSE: Home  
 (home, irrigation, municipal, industrial)


- WELL COMPLETION DATA:
- (1) diameter (inches) 4
  - (2) total depth (feet) 220
  - (3) static water level (feet) 150 below above top of ground.
  - (4) casing PVC, 220  
 (material) (depth)  
 (size) If telescope see back.
  - (5) screen 24, 213  
 (length) (depth to top)  
4" GRAVEL  
 (size) (material)
  - (6) pump 3/4 10  
 (HP) (yield gpm)  
220  
 (type power)
  - (7) electric log No  
 (yes or no)  
 (organization running log)
  - (8) how well bottom plugged CAP

DRILLERS REMARKS:

RECEIVED  
 JUN 28 1976

If well telescopes please sketch and show depths.

GROUND LEVEL

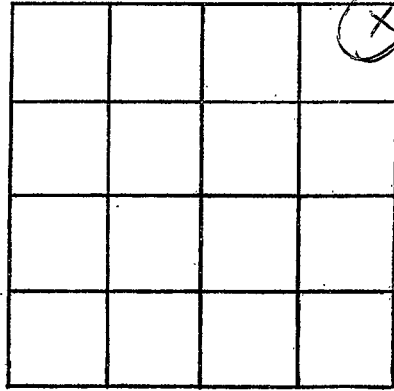

SECTION 2

Please indicate well location X.

ADDITIONAL INFORMATION

If more than one screen,  
show locations of each on sketch.