

Marshall  
 205  
 7-12-76

MISSISSIPPI  
 BOARD OF WATER COMMISSIONERS  
 416 North State Street  
 Jackson, Mississippi 39201

WATER WELL DRILLERS LOG

7-12 1976 date well completed  
 Hicks Well Co firm name  
 Marshall county well located

LANDOWNER: <u>Granite Center</u>	Description of formations encountered	from	to
<u>Holly Springs, Miss</u> (mailing address)	<u>Red clay + Sand</u>	0	40
WELL LOCATION: sec. <u>22 T 84 N</u> ? R <u>3 E</u>	<u>White Sand</u>	40	120
<u>3</u> miles <u>S</u> of <u>Holly Springs</u> (distance) (direction) (nearest town)	<u>White Clay + Sand</u>	120	240
WELL PURPOSE: <u>Home</u> (home, irrigation, municipal, industrial)	<u>White Sand</u>	240	320
WELL COMPLETION DATA:			
(1) diameter (inches) <u>4</u>			
(2) total depth (feet) <u>320</u>			
(3) static water level (feet) <u>280</u> below above top of ground.			
(4) casing <u>PVC</u> , <u>250</u> (material) (depth)			
_____ if telescope see back: (size)			
(5) screen <u>7' 0"</u> , <u>3' 13"</u> (length) (depth to top)			
_____ gravel (size) (material)			
(6) pump <u>3/4</u> , <u>5</u> (HP) (yield gpm)			
<u>220</u> (type power)			
(7) electric log <u>NO</u> (yes or no)			
_____ (organization running log)			
(8) how well bottom plugged <u>gravel</u> <u>and sand</u>			
DRILLERS REMARKS:			


RECEIVED

JUL 28 1976

MISS. BD. OF WATER COMM

If well telescopes please sketch and show depths.

GROUND LEVEL

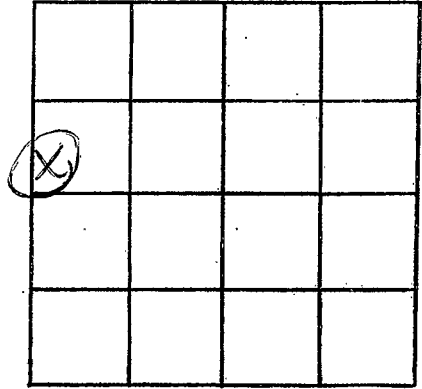

SECTION 22

Please indicate well location X.

ADDITIONAL INFORMATION

If more than one screen,  
show locations of each on sketch.