

Marshall  
 2007  
 12/10/76

MISSISSIPPI  
 BOARD OF WATER COMMISSIONERS  
 416 North State Street  
 Jackson, Mississippi 39201

WATER WELL DRILLERS LOG

12-10-1976 date well completed  
 15E High Wells Co. firm name  
 Marshall county well located

LANDOWNER: David Bowen

description of formations encountered	depth	
	from	to
Red Clay	0	11
Red Sand	11	40
Bank Clay	40	80
Clay & Sand	80	140
White Sand	140	200

Rt. 1  
 Holly Springs, Ms.  
 (mailing address)

WELL LOCATION:  
 sec. 11 T. 4 N. R. 3 E.  
 2 1/2 miles SW of Holly Springs  
 (distance) (direction) (nearest town)

MSW

WELL PURPOSE: ~~home~~  
 (home, irrigation, municipal, industrial)

WELL COMPLETION DATA:

- (1) diameter (inches) 4"
- (2) total depth (feet) 200
- (3) static water level (feet) 175 Below top of ground.
- (4) casing PVC 200 (material) (depth)  
 (size) If telescope see back.
- (5) screen 7' 193' (length) (depth to top)  
 4" Gravel (size) (material)
- (6) pump 3/4 (HP) 10 (yield gpm)  
 220V (type power)
- (7) electric log No (yes or no)
- (organization running log)
- (8) how well bottom plugged Cap


DRILLERS REMARKS:

RECEIVED  
 JAN 2 1977

MISS. BD OF WATER COMMISSIONERS

If well telescopes please sketch and show depths.

GROUND LEVEL

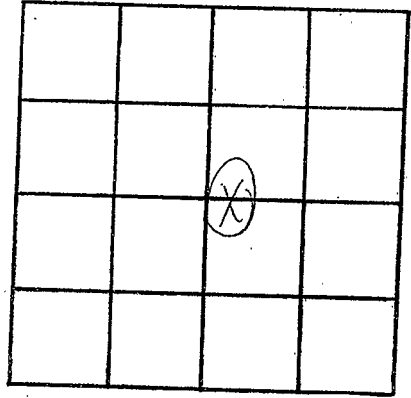

SECTION 77

Please indicate well location X.

ADDITIONAL INFORMATION

Lined area for additional information.

If more than one screen, show locations of each on sketch.