

**MARSHALL**  
 P 2008  
 5-6-77

MISSISSIPPI  
 BOARD OF WATER COMMISSIONERS  
 416 North State Street  
 15E Jackson, Mississippi 39201

**WATER WELL DRILLERS LOG**

5-6 1977 Deepest Enterprises Marshall  
 date well completed firm name county well located

LANDOWNER:  
Walter F Boyd  
At 4 Holly Springs, Miss  
 (mailing address)

description of formations encountered	from	to
clay	0	20
sand	20	147

WELL LOCATION:  
 sec 6 T 4 N R 3 E  
6 miles west of Boals  
 (distance) (direction) (nearest town)

WELL PURPOSE: Drinking  
 (home, irrigation, municipal, industrial)

- WELL COMPLETION DATA:
- (1) diameter (inches) 4"
  - (2) total depth (feet) 147 feet
  - (3) static water level (feet) 20 below above top of ground.
  - (4) casing PVC, 147 feet  
 (material) (depth)  
 (size) if telescope see back.
  - (5) screen 7ft, 140 feet  
 (length) (depth to top)  
4", Iron pipe  
 (size) (material)
  - (6) pump 3/4 14  
 (HP) (yield gpm)  
 (type power)
  - (7) electric log elect  
 (yes or no)  
 (organization running log)
  - (8) how well bottom plugged 4" cpi


**RECEIVED**  
 JUN 8 1977

MISS. BD. OF WATER COMMISSIONERS

DRILLERS REMARKS:

If well telescopes please sketch and show depths.

GROUND LEVEL

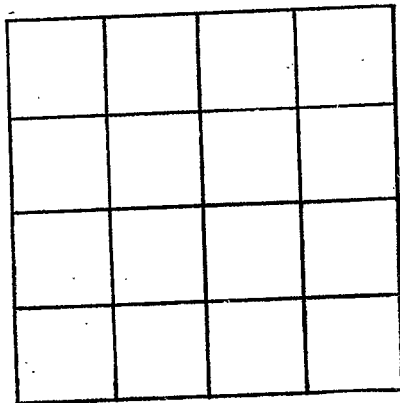

SECTION \_\_\_\_\_

Please indicate well location X.

ADDITIONAL INFORMATION

If more than one screen, show locations of each on sketch..