

Marshall  
 2009  
 5-10-77

MISSISSIPPI  
 BOARD OF WATER COMMISSIONERS  
 416 North State Street  
 Jackson, Mississippi 39201

WATER WELL DRILLERS LOG

5-10 1977 Dean Hart Surf well Co. Marshall  
 date well completed firm name county well located

LANDOWNER:  
Bentley Co.  
Healy Springs, Miss.  
 (mailing address)

description of formations encountered  
Sand  
 from 0 to 150

WELL LOCATION:  
 sec. 13 T. 4 N. R. 3 E.  
2 miles South of Healy Springs  
 (distance) (direction) (nearest town)

WELL PURPOSE: Dwelling  
 (home, irrigation, municipal, industrial)

WELL COMPLETION DATA:  
 (1) diameter (inches) 4"  
 (2) total depth (feet) 150 feet  
 (3) static water level (feet) 80 below top of ground.  
 (4) casing PVC, 150 feet  
 (material) (depth)  
 \_\_\_\_\_ If telescope see back.  
 (size)  
 (5) screen 7 ft., 143 feet  
 (length) (depth to top)  
4", Sand waf.  
 (size) (material)  
 (6) pump 3/4, 19  
 (HP) (yield/gpm)  
 \_\_\_\_\_  
 (type power)  
 (7) electric log Elect.  
 (yes or no)  
 \_\_\_\_\_  
 (organization running log)  
 (8) how well bottom plugged 4' cap.


RECEIVED  
 JUN 8 1977

MISS. RD. OF WATER COMMISSIONERS

DRILLERS REMARKS:

If well telescopes please sketch and show depths.

GROUND LEVEL

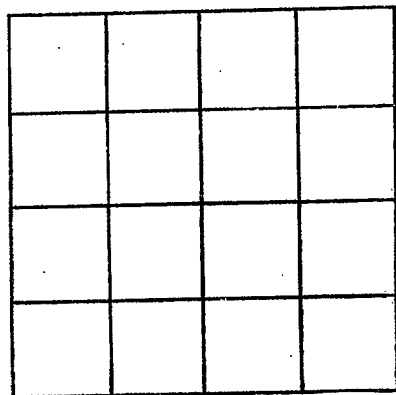

SECTION \_\_\_\_\_

Please indicate well location X.

ADDITIONAL INFORMATION

If more than one screen, show locations of each on sketch.