

MARSHALL

0 2010

4-27-18

MISSISSIPPI BOARD OF WATER COMMISSIONERS  
416 North State Street  
Jackson, Mississippi 39201

WATER WELL DRILLERS LOG

4-27-18 19 28 Permit # 28-10-10-10 Marshall  
date well completed firm name county well located

LANDOWNER:

DATION Jones

Holly Springs, Miss.  
(mailing address)

description of formations encountered

from to

Clay 0 20  
Sand 20 220

WELL LOCATION:

sec 5 T 4 N R 3 E  
(S) (W)  
5 miles WEST of Holly Springs  
(distance) (direction) (nearest town)

WELL PURPOSE: Drinking  
(home, irrigation, municipal, industrial)

WELL COMPLETION DATA:

- (1) diameter (inches) 4"
- (2) total depth (feet) 220 feet
- (3) static water level (feet) 165 below top of ground
- (4) casing PVC, 220 feet (material) (depth)  
(size) if telescope see back.
- (5) screen 7 ft., 193 feet (length) (depth to top)  
4" gravel wash (size) (material)
- (6) pump 3/4 HP, 14 (yield/gpm)  
(type power)
- (7) electric log Elec. (yes or no)  
(organization running log)
- (8) how well bottom plugged 4" cap


DRILLERS REMARKS:

RECEIVED  
MAY 9 1978

MISS. BD. OF WATER COMM

If well telescopes please sketch and show depths.

GROUND LEVEL

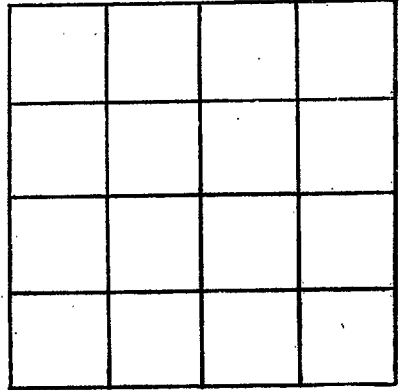

SECTION \_\_\_\_\_

Please indicate well location X.

ADDITIONAL INFORMATION

If more than one screen, show locations of each on sketch.