

MARSHALL

0 2011

6/2/78

MISSISSIPPI
 BOARD OF WATER COMMISSIONERS
 416 North State Street
 Jackson, Mississippi 39201

WATER WELL DRILLERS LOG

6-2 19 78 Deerport Burial Marshall
 date well completed firm name county well located

LANDOWNER:

Leroy Johnson
Halls Springs, Miss
 (mailing address)

description of formations encountered

from to

Sand	0	40
Clay	40	50
Sand	50	130

WELL LOCATION:

sec. 17 T. 4 N. R. 3 E.
6 miles West of Halls Springs
 (distance) (direction) (nearest town)

WELL PURPOSE: Drinking
 (home, irrigation, municipal, industrial)

WELL COMPLETION DATA:

- (1) diameter (inches) 4"
- (2) total depth (feet) 130 feet
- (3) static water level (feet) 60 below above top of ground.
- (4) casing PVC 130 feet
 (material) (depth)
 (size) If telescope see back.
- (5) screen 7 1/2' 123 feet
 (length) (depth to top)
4" gravel wall
 (size) (material)
- (6) pump 3/4 14
 (HP) (yield gpm)
 (type power)
- (7) electric log slat.
 (yes or no)
 (organization running log)
- (8) how well bottom plugged 4" cap.


DRILLERS REMARKS:

RECEIVED
 JUL 11 1978

MISS. BD. OF WATER COMMISSIONERS

If well telescopes please sketch and show depths.

GROUND LEVEL

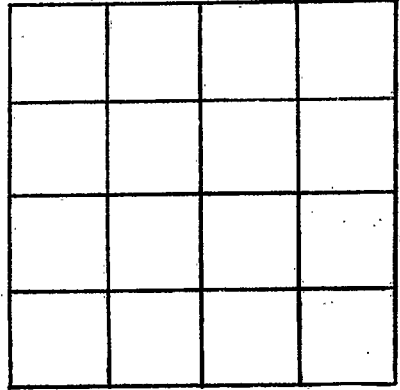

SECTION _____

Please indicate well location X.

ADDITIONAL INFORMATION

If more than one screen, show locations of each on sketch.