

MARSHALL

0 2012

6/15/68

MISSISSIPPI BOARD OF WATER COMMISSIONERS
416 North State Street
Jackson, Mississippi 39201

WATER WELL DRILLERS LOG

6-15 1968 Dean Kent B... Marshall
date well completed firm name county well located

LANDOWNER:

Marshall Mitchell
Rt 3, Holly Springs, Miss.
(mailing address)

description of formations encountered

from to

Clay	0	20
Sand	20	50
Clay	50	65
Sand	65	140

WELL LOCATION:

sec. 17 T 4 N R 3 E
6 miles west of Holly Springs
(distance) (direction) (nearest town)

WELL PURPOSE: Domestic
(home, irrigation, municipal, industrial)

WELL COMPLETION DATA:

- (1) diameter (inches) 4"
- (2) total depth (feet) 140 feet
- (3) static water level (feet) 70 below top of ground.
- (4) casing PVC 140 feet (material) (depth)
- (size) If telescope see back.
- (5) screen 74" 133 feet (length) (depth to tap)
- 4" gravel wall (size) (material)
- (6) pump 3/4 HP 14 (yield/gpm)
- (type power)
- (7) electric log Elec. (yes or no)
- (organization running log)

(8) how well bottom plugged 4" cap

DRILLERS REMARKS:


RECEIVED

JUL 11 1978

MISS. BD. OF WATER COMM

If well telescopes please sketch and show depths.

GROUND LEVEL

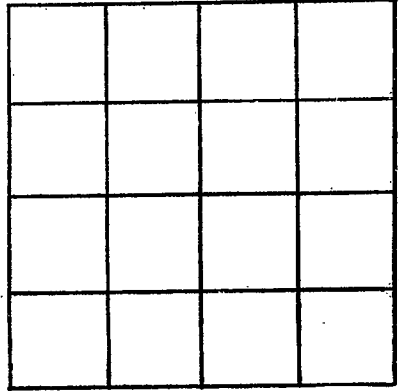

SECTION _____

Please indicate well location X.

ADDITIONAL INFORMATION

If more than one screen, show locations of each on sketch.