

MARSHALL
0 2013
8-12-78

**MISSISSIPPI
BOARD OF WATER COMMISSIONERS**
416 North State Street
Jackson, Mississippi 39201

WATER WELL DRILLERS LOG

Aug. 12 1978 Earl Jones Well Co. Marshall
 date well completed firm name county well located


LANDOWNER:	description of formations encountered	from	to
<u>John Burton</u>			
<u>Holly Springs Miss. RT 3</u> (mailing address)	<u>Topsoil & clay</u>	<u>0</u>	<u>16</u>
	<u>sand</u>	<u>16</u>	<u>44</u>
	<u>clay</u>	<u>44</u>	<u>50</u>
	<u>sand</u>	<u>50</u>	<u>88</u>
	<u>clay</u>	<u>88</u>	<u>94</u>
	<u>sand</u>	<u>94</u>	<u>160</u>
	<u>clay</u>	<u>160</u>	<u>164</u>
	<u>sand</u>	<u>164</u>	<u>215</u>
WELL LOCATION: sec. <u>28</u> T. <u>24</u> N. R. <u>3</u> E. <u>3</u> W. <u>4</u> miles (distance) <u>SW</u> (direction) of <u>Holly Springs</u> (nearest town)			
WELL PURPOSE: <u>Home</u> (home, irrigation, municipal, industrial)			
WELL COMPLETION DATA:			
(1) diameter (inches) <u>4"</u>			
(2) total depth (feet) <u>215</u>			
(3) static water level (feet) <u>180</u> below/above top of ground.			
(4) casing <u>plastic</u> (material) <u>205</u> (depth)			
<u>4"</u> (size) If telescope see back.			
(5) screen <u>10'</u> (length) <u>205</u> (depth to top)			
<u>4"-013</u> (size) <u>plastic</u> (material)			
(6) pump <u>3/4</u> (HP) <u>16</u> (yield gpm)			
<u>Electric</u> (type power)			
(7) electric log <u>No</u> (yes or no)			
(organization running log)			
(8) how well bottom plugged <u>plastic core</u>			
DRILLERS REMARKS:			

RECEIVED
SEP 13 1978

WATER COMMISSIONERS

If well telescopes please sketch and show depths.

GROUND LEVEL

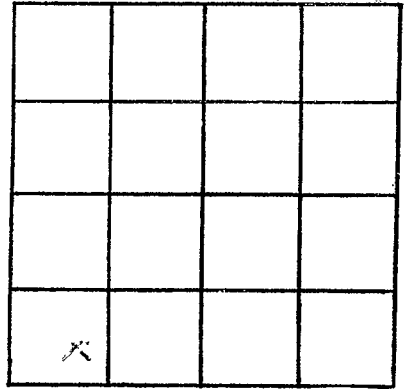

SECTION 28'

Please indicate well location X.

ADDITIONAL INFORMATION

If more than one screen, show locations of each on sketch.