

MARSHALL

0 2014

9-06-77

MISSISSIPPI BOARD OF WATER COMMISSIONERS  
416 North State Street  
Jackson, Mississippi 39201

WATER WELL DRILLERS LOG

Sept 6

1977

R.L. Carpenter

Marshall

date well completed

firm name

county well located

LANDOWNER:

Hellie Smith

Holly Springs, Miss

RFD

(mailing address)

WELL LOCATION:

sec. 37 T-4 N R-3 E  
S W

7 miles Southeast of Holly Springs  
(distance) (direction) (nearest town)

WELL PURPOSE:

None

(home, irrigation, municipal, industrial)

WELL COMPLETION DATA:

- (1) diameter (inches) 4
- (2) total depth (feet) 158
- (3) static water level (feet) 122 below top of ground.
- (4) casing Plastic 148 (material) (depth)
- (size) If telescope see back.
- (5) screen 18' 148' (length) (depth to top)
- 4" Plastic (size) (material)
- (6) pump 1/2 8 (HP) (yield gpm)
- Elec. (type power)
- (7) electric log No. (yes or no)

(organization running log)

(8) how well bottom plugged

PVC Cap

description of formations encountered

from

to

Surface Soil

0 20

Coarse Red Sand

20 53

White Clay & white F.S. Sand

53 75

Med. White Sand

75 110

Coarse White Sand

110 158

Miss. Board of Water Comm.


MAR 12 1979

RECEIVED

DRILLERS REMARKS:

If well telescopes please sketch and show depths.

GROUND LEVEL

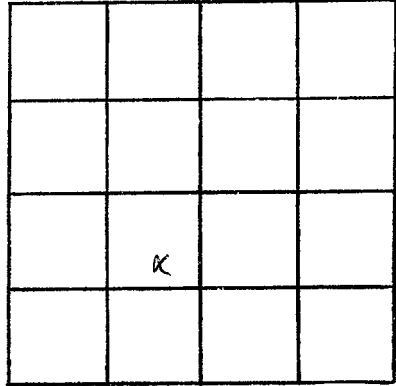

SECTION 31

Please indicate well location X.

ADDITIONAL INFORMATION

If more than one screen,  
show locations of each on sketch.