

MARSHALL

0 2015

5-20-77

MISSISSIPPI BOARD OF WATER COMMISSIONERS
416 North State Street
Jackson, Mississippi 39201

WATER WELL DRILLERS LOG

May 20 1977
date well completed

R. L. Carpenter
firm name

Marshall
county well located

LANDOWNER: O. C. Pegues
Holly Springs
Miss.
(mailing address)

description of formations encountered

from

to

Surface Soil	8	22
Med white sand	22	45
Med. & Fine white sand	45	83
White Clay	83	120
Coarse white sand	120	145
White Clay	145	178
White Coarse sand	178	220

WELL LOCATION:

sec. 25 T. 4 N R. 3 E
S W
4 miles South of Holly Springs
(distance) (direction) (nearest town)

WELL PURPOSE: None
(home, irrigation, municipal, industrial)

WELL COMPLETION DATA:

- (1) diameter (inches) 16
- (2) total depth (feet) 220
- (3) static water level (feet) 150 below top of ground.
- (4) casing Plastic, 210' (material) (depth)
(size) if telescope see back.
- (5) screen 18' length, 210' depth to top
4" size, Plastic material
- (6) pump 3/4 HP, 10 yield gpm
Eber type power
- (7) electric log No (yes or no)

(organization running log)

(8) how well bottom plugged PVC Cap

DRILLERS REMARKS:


Miss. Board of Water Comm.

MAR 12 1979

RECEIVED

If well telescopes please sketch and show depths.

GROUND LEVEL

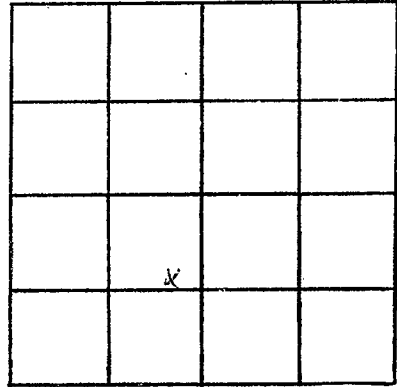

SECTION 215

Please indicate well location X.

ADDITIONAL INFORMATION

If more than one screen,
show locations of each on sketch.