

MARSHALL

0 2016

7-13-79

MISSISSIPPI
 BOARD OF WATER COMMISSIONERS
 416 North State Street
 Jackson, Mississippi 39201

4

WATER WELL DRILLERS LOG

7-13
date well completed

19 29 Deont Kat Sub ^{well}
firm name

Marshall
county well located

LANDOWNER:	description of formations encountered	from	to
Aaron Jones Holly Springs, Miss (mailing address)			
WELL LOCATION:	Sand	20	60
sec. 17 T 4 N R 3 E 6 miles west of Holly Springs (distance) (direction) (nearest town)	Clay	60	65
WELL PURPOSE: Drilling (home, irrigation, municipal, industrial)	Sand	65	120
WELL COMPLETION DATA:	Clay	160	187
(1) diameter (inches) 4"	Sand	187	200
(2) total depth (feet) 200 feet			
(3) static water level (feet) 70 below top of ground.			
(4) casing PVC, 200 feet (material) (depth)			
(size) if telescope see back.			
(5) screen 7 ft, 183 feet (length) (depth to top)			
4" Gravel Wall (size) (material)			
(6) pump 3/4 (HP) 14 (yield/gpm)			
(type power)			
(7) electric log Elect. (yes or no)			
(organization running log)			
(8) how well bottom plugged 4" cap.			
DRILLERS REMARKS:			


Miss. Board of Water Comm.

AUG 8 1979

RECEIVED

If well telescopes please sketch and show depths.

GROUND LEVEL

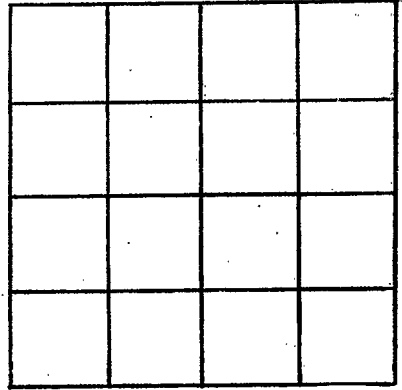

SECTION _____

Please indicate well location X.

ADDITIONAL INFORMATION

If more than one screen,
show locations of each on sketch.