

MARSHALL

0 2017

7-21-79

MISSISSIPPI BOARD OF WATER COMMISSIONERS
416 North State Street
Jackson, Mississippi 39201

WATER WELL DRILLERS LOG

7-21 19 79 Rich Wells Marshall
date well completed firm name county well located

LANDOWNER:	description of formations encountered	from	to
Ollie Coleman Rt. 3 - Bayoulic, Miss (mailing address)	Red clay	0	30
	Red sand	20	80
WELL LOCATION: sec. <u>30</u> T. <u>4</u> N. R. <u>3</u> E <u>3 1/2</u> miles <u>NW</u> of <u>Sloma</u> (distance) (direction) (nearest town)	White sand	80	125
WELL PURPOSE: <u>house</u> (home, irrigation, municipal, industrial)	Red sand	30	100
WELL COMPLETION DATA:	White sand	100	222
(1) diameter (inches) <u>4 in</u>			
(2) total depth (feet) <u>222</u>			
(3) static water level (feet) _____ below top of ground. above			
(4) casing <u>Plastic 215</u> (material) (depth) (size) if telescope see back.			
(5) screen <u>714</u> <u>215</u> (length) (depth to top)			
<u>4 in</u> <u>brass</u> (size) (material)			
(6) pump <u>1/2</u> <u>10</u> (HP) (yield gpm)			
<u>220</u> (type power)			
(7) electric log <u>No</u> (yes or no)			
(organization running log)			
(8) how well bottom plugged <u>Cap</u>			
DRILLERS REMARKS:			


Miss. Board of Water Comm.

AUG 1 1979

RECEIVED

If well telescopes please sketch and show depths.

GROUND LEVEL

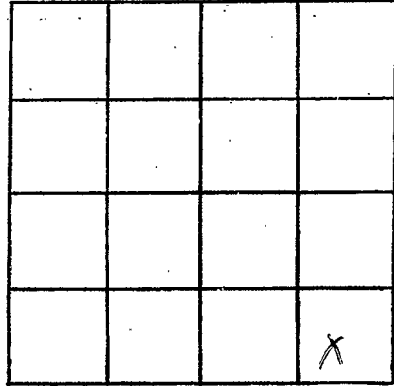

SECTION 30

Please indicate well location X.

ADDITIONAL INFORMATION

A series of horizontal lines for writing additional information.

If more than one screen, show locations of each on sketch.