

Marshall  
 O  
 2018  
 10-19-79

MISSISSIPPI  
 BOARD OF WATER COMMISSIONERS  
 416 North State Street  
 Jackson, Mississippi 39201

WATER WELL DRILLERS LOG

10-19 1979 Leitch Well Co. Marshall  
 date well completed firm name county well located

LANDOWNER:  
 Willie Joe Finley  
 Rt. 3, Wally Springs  
 (mailing address)

description of formations encountered	from	to
clay	0	30
Red sand	30	120
white sand	120	230

WELL LOCATION:  
 sec. 32 T 4 N R 3 E  
 Saloma  
 (distance) miles (direction) of (nearest town)

WELL PURPOSE: home  
 (home, irrigation, municipal, industrial)


- WELL COMPLETION DATA:
- diameter (inches) 4 in
  - total depth (feet) 230
  - static water level (feet) \_\_\_\_\_ below above top of ground.
  - casing Plastic 230 (material) (depth)  
 (size) if telescope see back.
  - screen 7 ft 223 (length) (depth to top)  
 4 in Gravel (size) (material)
  - pump 1/2 HP 10 (type power) (yield gpm)  
 220 (type power)
  - electric log No (yes or no)
  - (organization running log)
  - how well bottom plugged Cap

DRILLERS REMARKS:

DEPT. OF NATURAL RESOURCES  
 BUREAU OF LAND & WATER RESOURCES  
 NOV 13 1979  
 RECEIVED

If well telescopes please sketch and show depths.

GROUND LEVEL

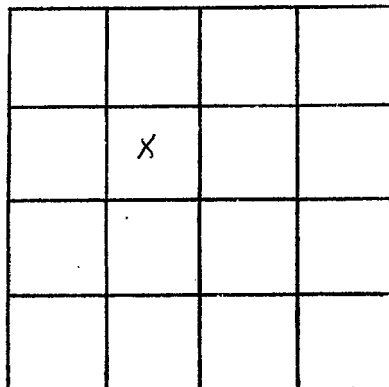

SECTION 32

Please indicate well location X.

ADDITIONAL INFORMATION

If more than one screen,  
show locations of each on sketch.