

Marshall  
 2021  
 5-28-79

MISSISSIPPI  
 BOARD OF WATER COMMISSIONERS  
 416 North State Street  
 Jackson, Mississippi 39201

WATER WELL DRILLERS LOG

5-28 1979 date well completed  
 Dean + Kent Bunge firm name  
 Marshall county well located


LANDOWNER:	description of formations encountered	from	to
Clay Jones	clay	0	20
Halls Springs, Miss. (mailing address)	sand	20	180

WELL LOCATION:  
 sec. 4 T. 4 N. R. 3 E.  
 7 miles west of Halls Springs  
 (distance) (direction) (nearest town)

WELL PURPOSE: Drill  
 (home, irrigation, municipal, industrial)


- WELL COMPLETION DATA:
- (1) diameter (inches) 4"
  - (2) total depth (feet) 180 ft
  - (3) static water level (feet) 120 ft below/above top of ground.
  - (4) casing PVC, 180 ft  
 (material) (depth)  
 (size) If telescope see back.
  - (5) screen 24", 173 ft  
 (length) (depth to top)  
4", drum wall  
 (size) (material)
  - (6) pump 3/4, 14  
 (HP) (yield/gpm)  
 (type power)
  - (7) electric log Elect.  
 (yes or no)  
 (organization running log)
  - (8) how well bottom plugged 4"

DRILLERS REMARKS:

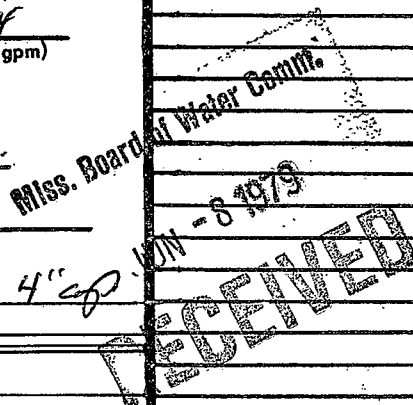

If well telescopes please sketch and show depths.

GROUND LEVEL

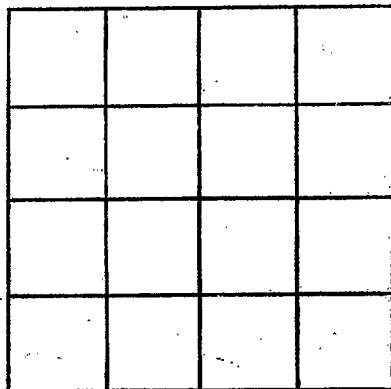

SECTION \_\_\_\_\_

Please indicate well location X.

ADDITIONAL INFORMATION

If more than one screen,  
show locations of each on sketch.