

MARSHALL
 2022
 5-24-79

MISSISSIPPI
 BOARD OF WATER COMMISSIONERS
 416 North State Street
 Jackson, Mississippi 39201

WATER WELL DRILLERS LOG


5-24 1979 Dean Kent Benge & Co. Marshall
 date well completed firm name county well located

LANDOWNER:	description of formations encountered	from	to
<u>Ked Glass</u>			
<u>Holly Springs, Miss.</u> (mailing address)	<u>clay</u>	<u>0</u>	<u>30</u>
WELL LOCATION:	<u>sand</u>	<u>30</u>	<u>200</u>
sec. <u>30</u> T. <u>4</u> N. R. <u>3</u> E	<u>clay</u>	<u>200</u>	<u>215</u>
<u>4</u> miles <u>South</u> of <u>Holly Springs</u> (distance) (direction) (nearest town)	<u>sand</u>	<u>215</u>	<u>260</u>
WELL PURPOSE: <u>Drilling</u> (home, irrigation, municipal, industrial)			
WELL COMPLETION DATA:			
(1) diameter (inches) <u>4"</u>			
(2) total depth (feet) <u>260 feet</u>			
(3) static water level (feet) <u>217</u> below top of ground.			
(4) casing <u>PVC</u> , <u>260 feet</u> (material) (depth)			
(size) If telescope see back.			
(5) screen <u>7ft.</u> , <u>253 feet</u> (length) (depth to top)			
<u>4"</u> , <u>gravel wall</u> (size) (material)			
(6) pump <u>3/4</u> , <u>10</u> (HP) (yield gpm)			
(type power)			
(7) electric log <u>Elect.</u> (yes or no)			
(organization running log)			
(8) how well bottom plugged <u>4" cap</u>			
DRILLERS REMARKS:			

Miss. Board of Water Comm.
 JUN - 8 1979
 RECEIVED

If well telescopes please sketch and show depths.

GROUND LEVEL

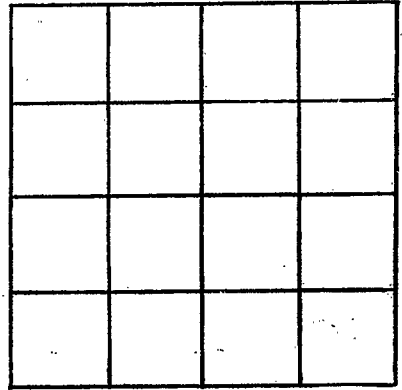

SECTION _____

Please indicate well location X.

ADDITIONAL INFORMATION

If more than one screen, show locations of each on sketch.