

MARSHALL
 2023
 6-14-79

MISSISSIPPI
 BOARD OF WATER COMMISSIONERS
 416 North State Street
 Jackson, Mississippi 39201

WATER WELL DRILLERS LOG

6-14 19 79 Hecho Well Co Marshall
 date well completed firm name county well located

LANDOWNER:
Lenny DeBarry
Rt. 5, Holly Springs, Miss
 (mailing address)

description of formations encountered	from	to
Red Clay	0	20
Red Sand	20	70
White Clay	70	120
White sand & clay	120	245
White sand	245	325

WELL LOCATION:
 sec. 23 T. 4 N R. 3 E
3 1/2 miles SW of Holly Springs
 (distance) (direction) (nearest town)

WELL PURPOSE: home
 (home, irrigation, municipal, industrial)

WELL COMPLETION DATA:
 (1) diameter (inches) 4 in
 (2) total depth (feet) 335
 (3) static water level (feet) _____ below/above top of ground.
 (4) casing Plastic 335
 (material) (depth)
 _____ If telescope see back.
 (size)
 (5) screen 4 ft, 328
 (length) (depth to top)
4 in, brass
 (size) (material)
 (6) pump 3/4 14
 (HP) (yield gpm)
220
 (type power)
 (7) electric log No
 (yes or no)

 (organization running log)
 (8) how well bottom plugged Cap

Miss. Board of Water Comm.


JUN 29 1979

DRILLERS REMARKS:

RECEIVED

If well telescopes please sketch and show depths.

GROUND LEVEL

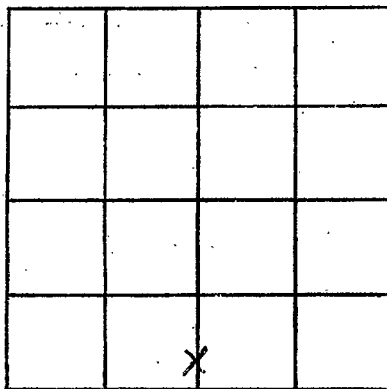

SECTION 23

Please indicate well location X.

ADDITIONAL INFORMATION

If more than one screen, show locations of each on sketch.