

MARSHALL
 2024
 6-11-79

MISSISSIPPI
 BOARD OF WATER COMMISSIONERS
 416 North State Street
 Jackson, Mississippi 39201

WATER WELL DRILLERS LOG

6-11-79 date well completed
 Dentket Bumpers well firm name
 Marshall county well located

LANDOWNER:	description of formations encountered	from	to
Pat Ellis, Stebbins			
Holly Springs, Miss. (mailing address)	sand	40	200

WELL LOCATION:
 sec. 1 T 4 N R 3 E
 2 miles west of Holly Springs
 (distance) (direction) (nearest town)

WELL PURPOSE: Drinking
 (home, irrigation, municipal, industrial)

- WELL COMPLETION DATA:
- (1) diameter (inches) 4"
 - (2) total depth (feet) 200 feet
 - (3) static water level (feet) 100 below top of ground.
 - (4) casing PVC 200 feet
 (material) (depth)
 (size) If telescope see back.
 - (5) screen HT 19 3/4 feet
 (length) (depth to top)
4" gravel wall
 (size) (material)
 - (6) pump 3/4 14
 (HP) (yield gpm)
 (type power)
 - (7) electric log Elaf.
 (yes or no)
 (organization running log)
 - (8) how well bottom plugged 4" Cof.

DRILLERS REMARKS:


Miss. Board of Water Comm.

JUL 5 1979

RECEIVED

If well telescopes please sketch and show depths.

GROUND LEVEL

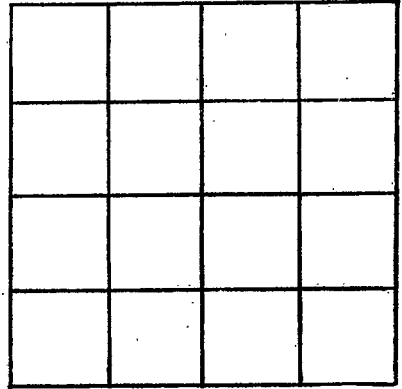

SECTION _____

Please indicate well location X.

ADDITIONAL INFORMATION

If more than one screen,
show locations of each on sketch.