

Marshall  
 0 2026  
 9-25-79

MISSISSIPPI  
 BOARD OF WATER COMMISSIONERS  
 416 North State Street  
 Jackson, Mississippi 39201

WATER WELL DRILLERS LOG

9-25 19 79 Deant Kat Binger & Son Marshall  
 date well completed firm name county well located

LANDOWNER:  
Robert Jones  
Marion Jones Miss  
 (mailing address)

description of formations encountered	from	to
<u>clay</u>	<u>0</u>	<u>20</u>
<u>Sand</u>	<u>20</u>	<u>120</u>

WELL LOCATION:  
 sec. 17 T. 4 N. R. 3 E. W. 3  
6 miles West of Holly Springs  
 (distance) (direction) (nearest town)

WELL PURPOSE: Shed  
 (home, irrigation, municipal, industrial)


- WELL COMPLETION DATA:
- (1) diameter (inches) 4"
  - (2) total depth (feet) 120 feet
  - (3) static water level (feet) 50 below above top of ground.
  - (4) casing PVC 120 feet  
 (material) (depth)  
 (size) If telescope see back.
  - (5) screen 7ft. 11.3 feet  
 (length) (depth to top)  
4" Gravel  
 (size) (material)
  - (6) pump 3/4 14  
 (HP) (yield/gpm)  
 (type power)
  - (7) electric log Elct.  
 (yes or no)  
 (organization running log)
  - (8) how well bottom plugged 4" conf.

DRILLERS REMARKS:

DEPT. OF NATURAL RESOURCES  
 BUREAU OF LAND & WATER RESOURCES  
 OCT 5 1979  
 RECEIVED  
 DEPT. OF NATURAL RESOURCES  
 BUREAU OF LAND & WATER RESOURCES  
 OCT 5 1979  
 RECEIVED

If well telescopes please sketch and show depths.

GROUND LEVEL

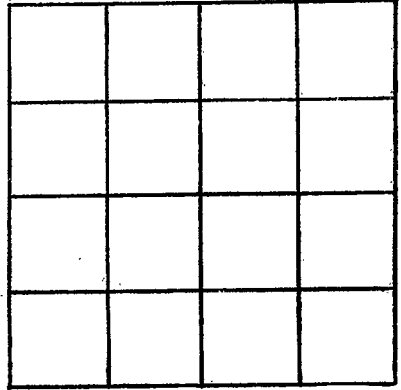

SECTION \_\_\_\_\_

Please indicate well location X.

ADDITIONAL INFORMATION

If more than one screen,  
show locations of each on sketch.