

Marshall  
Φ 208

MISSISSIPPI  
BOARD OF WATER COMMISSIONERS  
416 North State Street  
Jackson, Mississippi 39201

WATER WELL DRILLERS LOG

12-3-79

12.3

19

79 Richs Well Co.

Marshall

date well completed

firm name

county well located

LANDOWNER:	description of formations encountered	from	to
W. B. Conzill			
RD 3, Box 24, Holly Springs (mailing address)	clay	0	30
WELL LOCATION:	red sand	30	70
sec. 9 T 4 N R 3 E	white sand	70	155
4 miles W of Holly Springs (distance) (direction) (nearest town)			
WELL PURPOSE: Home (home, irrigation, municipal, industrial)			
WELL COMPLETION DATA:			
(1) diameter (inches) 1 5/8 in			
(2) total depth (feet) 155			
(3) static water level (feet) 100 below top of ground			
(4) casing Plastic 155 (material) (depth)			
(size) if telescope see back.			
(5) screen 7 ft 14 ft (length) (depth to top)			
4 in gravel (size) (material)			
(6) pump 1/2 10 (HP) (yield gpm)			
220 (type power)			
(7) electric log No (yes or no)			
(organization running log)			
(8) how well bottom plugged Cap			
DRILLERS REMARKS:			


DEPT. OF NATURAL RESOURCES  
BUREAU OF LAND & WATER RESOURCES

DEC 10 1979

RECEIVED

If well telescopes please sketch and show depths.

GROUND LEVEL

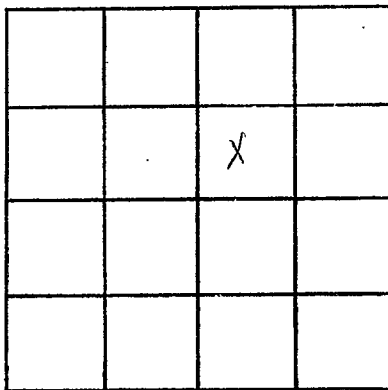

SECTION 9

Please indicate well location X.

ADDITIONAL INFORMATION

If more than one screen, show locations of each on sketch.