

Marshall

MISSISSIPPI
BOARD OF WATER COMMISSIONERS
416 North State Street
Jackson, Mississippi 39201

WATER WELL DRILLERS LOG

2031
7-1-80
7-1

1980 Dawson & Son, Inc. Marshall
date well completed firm name county well located

LANDOWNER:
John P. Brown
Holly Springs, Miss.
(mailing address)

description of formations encountered	from	to
	<u>Clay</u>	<u>0</u>
<u>Sand</u>	<u>20</u>	<u>200</u>

WELL LOCATION:
sec 31 T 4 N R 3 E
10 miles S 1/2 E of Holly Springs
(distance) (direction) (nearest town)

WELL PURPOSE: Drinking
(home, irrigation, municipal, industrial)

- WELL COMPLETION DATA:
- (1) diameter (inches) 4"
 - (2) total depth (feet) 200 feet
 - (3) static water level (feet) 150 below above top of ground.
 - (4) casing PVC, 200 feet
(material) (depth)
(size) If telescope see back.
 - (5) screen 7 feet, 193 feet
(length) (depth to top)
4" gravel wall
(size) (material)
 - (6) pump 3/4 14
(HP) (yield gpm)
(type power)
 - (7) electric log Elect.
(yes or no)
(organization running log)
 - (8) how well bottom plugged 4" cgr.

DRILLERS REMARKS:


DEPT. OF NATURAL RESOURCES
BUREAU OF LAND & WATER RESOURCES

JUL 16 1980

RECEIVED

If well telescopes please sketch and show depths.

GROUND LEVEL

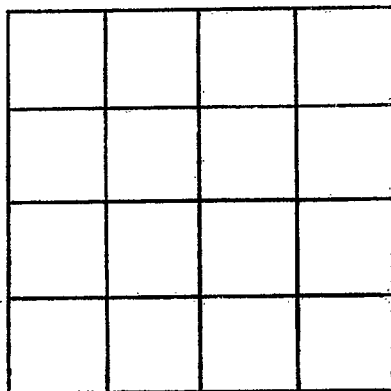

SECTION _____

Please indicate well location X.

ADDITIONAL INFORMATION

If more than one screen, show locations of each on sketch.