

MARSHALL

MISSISSIPPI
BOARD OF WATER COMMISSIONERS
416 North State Street
Jackson, Mississippi 39201

Q 2032

3-22-78

WATER WELL DRILLERS LOG

Mar. 22 1978
date well completed

R. L. Carpenter
firm name

Marshall
county well located

LANDOWNER: Oliver Finley
Holy Springs, Miss

(mailing address)

WELL LOCATION:

sec. 32 T-4 N R-3 E
7 miles southwest of H.S.
(distance) (direction) (nearest town)

WELL PURPOSE: Home
(home, irrigation, municipal, industrial)

WELL COMPLETION DATA:

- (1) diameter (inches) 4
- (2) total depth (feet) 260
- (3) static water level (feet) 133 below above top of ground.
- (4) casing Plastic, 190' (material) (depth)
(size) if telescope see back.
- (5) screen 10' 190' (length) (depth to top)
4" Plastic (size) (material)
- (6) pump 3/4 18 (HP) (yield gpm)
Elex (type power)
- (7) electric log No. (yes or no)

(organization running log)

(8) how well bottom plugged PVC Cap

DRILLERS REMARKS:

description of formations encountered

from to

Surface Soil	0	20
Red Red Sand	20	42
med white sand	42	90
White Clay & White Fined Sand	90	125
Red white sand	125	170
white coarse sand	170	200


DEPT. OF NATURAL RESOURCES
BUREAU OF LAND & WATER RESOURCES

JUL 23 1980

RECEIVED

If well telescopes please sketch and show depths.

GROUND LEVEL

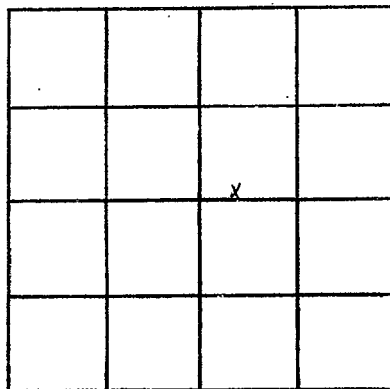

SECTION 32

Please indicate well location X.

ADDITIONAL INFORMATION

If more than one screen,
show locations of each on sketch.