

MISSISSIPPI DEPARTMENT OF NATURAL RESOURCES  
Bureau of Land and Water Resources  
Southport Mall  
P.O. Box 10631  
Jackson, Mississippi 39209  
WATER WELL DRILLERS LOG

Marshall  
Ø 2033  
3-27-81

3-27 1981 Daunt Kent Pumpers well Marshall  
date well completed firm name county well located

LANDOWNER:	description of formations encountered	from	to
<u>Lewis Clark</u>	<u>clay</u>	<u>0</u>	<u>10</u>
<u>Holly Springs miss</u> (mailing address)	<u>Sand</u>	<u>10</u>	<u>30</u>
	<u>clay</u>	<u>30</u>	<u>40</u>
	<u>Sand</u>	<u>40</u>	<u>130</u>

WELL LOCATION:  
sec. 5 T. 2 R. 4 W. 3  
6 miles S.W. of Holly Springs  
(distance) (direction) (nearest town)

WELL PURPOSE: Dwelling  
(home, irrigation, municipal, industrial)

WELL COMPLETION DATA:

(1) diameter (inches) 4"

(2) total depth (feet) 130 feet

(3) static water level (feet) 20 below above top of ground.

(4) casing pvc, 130 feet  
(material) (depth)  
(size) If telescope see back.

(5) screen 7 ft, 123 feet  
(length) (depth to top)  
4" gravel wall  
(size) (material)

(6) pump 3/4 14  
(HP) (yield gpm)  
(type power)

(7) electric log Elect.  
(yes or no)  
(organization running log)


(8) how well bottom plugged 4" cap

DRILLERS REMARKS:

DEPT. OF NATURAL RESOURCES  
BUREAU OF LAND & WATER RESOURCES  
APR - 9 1981  
RECEIVED

If well telescopes please sketch and show depths.

GROUND LEVEL

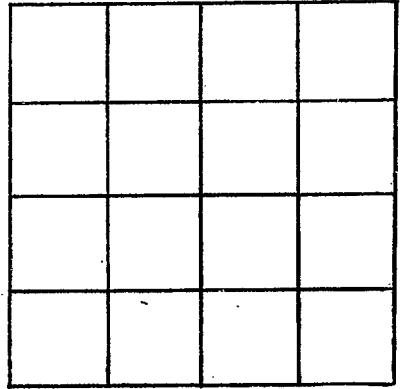

SECTION \_\_\_\_\_

Please indicate well location X.

ADDITIONAL INFORMATION

If more than one screen,  
show locations of each on sketch.