

MISSISSIPPI DEPARTMENT OF NATURAL RESOURCES

Bureau of Land and Water Resources

Southport Mall

P.O. Box 10631

Jackson, Mississippi 39209

WATER WELL DRILLERS LOG

Marshall
0234
7-20-81

7-20-81 19 Wilson Well Co., Inc Marshall
 date well completed firm name county well located

LANDOWNER:

McIntyre Baptist Church
PO Box 103
Holly Springs, MS 38635
 (mailing address)

description of formations encountered

	from	to
<u>Red clay - Red Sand</u>	<u>0</u>	<u>30</u>
<u>Red Sand</u>	<u>30</u>	<u>120</u>
<u>Red Sand - White clay - White Sand</u>	<u>120</u>	<u>135</u>
<u>White sand</u>	<u>135</u>	<u>195</u>

WELL LOCATION:

old Hwy 4
 sec 21 T 4 N R 3 E
6 miles S-W of Holly Springs
 (distance) (direction) (nearest town)

WELL PURPOSE:

church
 (home, irrigation, municipal, industrial)


WELL COMPLETION DATA:

- (1) diameter (inches) 4
- (2) total depth (feet) 195
- (3) static water level (feet) 130 below above top of ground.
- (4) casing Plastic (material) - (depth)
4 (size) if telescope see back.
- (5) screen 10 (length) - (depth to top)
4 (size) Plastic (material)
- (6) pump 3/4 (HP) 7 (yield gpm)
electric (type power)
- (7) electric log NO (yes or no)

(organization running log)


- (8) how well bottom plugged Plastic Cap 4"

DRILLERS REMARKS:

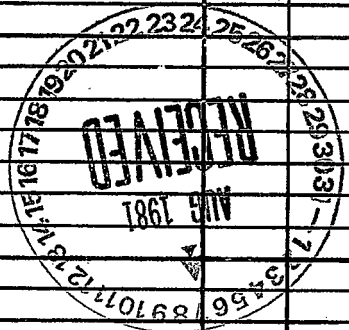

If well telescopes please
sketch and show depths.

GROUND LEVEL

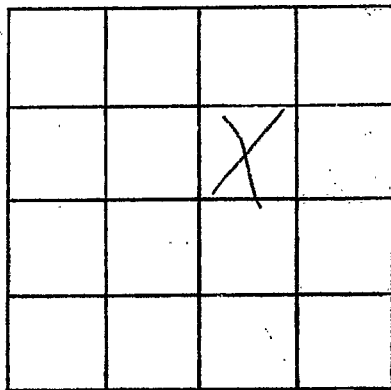

SECTION 21

Please indicate well location X.

ADDITIONAL INFORMATION

If more than one screen,
show locations of each on sketch.