

MISSISSIPPI DEPARTMENT OF NATURAL RESOURCES

Bureau of Land and Water Resources

Southport Mall

P.O. Box 10631

Jackson, Mississippi 39209

WATER WELL DRILLERS LOG

MARSHALL
Ø 2035
8/27/81
8-27-81
 date well completed

Wilson Well Co Marshall
 firm name county well located

LANDOWNER:
Murray Barthele
PO Box 695
Holly Springs Ms 38835
 (mailing address)

description of formations encountered	from	to
<u>Red clay Red sand</u>	<u>0</u>	<u>30</u>
<u>Red sand</u>	<u>30</u>	<u>60</u>
<u>White clay</u>	<u>60</u>	<u>120</u>
<u>White clay-White sand</u>	<u>120</u>	<u>150</u>
<u>White sand</u>	<u>150</u>	<u>237</u>

WELL LOCATION:
 sec 29 T 4 N R 3 E
6 miles SW of Holly Springs
 (distance) (direction) (nearest town)

WELL PURPOSE: Home
 (home, irrigation, municipal, industrial)

WELL COMPLETION DATA:
 (1) diameter (inches) 4
 (2) total depth (feet) 230
 (3) static water level (feet) 160 below above top of ground.
 (4) casing Plastic (material) (depth) 4 (size) if telescope see back.
 (5) screen 10 (length) (depth to top) 4 (size) Plastic (material)
 (6) pump 3/4 (HP) 7 (yield gpm) electric (type power)
 (7) electric log no (yes or no)

(organization running log)
 (8) how well bottom plugged Plastic Cap 4"

DRILLERS REMARKS: _____


DEPT. OF NATURAL RESOURCES
 BUREAU OF LAND & WATER RESOURCES

OCT 27 1981

RECEIVED

If well telescopes please sketch and show depths.

GROUND LEVEL

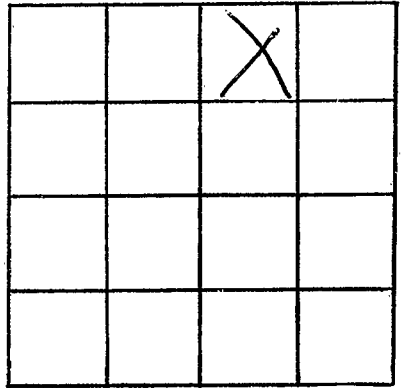

SECTION 29

Please indicate well location X.

ADDITIONAL INFORMATION

If more than one screen,
show locations of each on sketch.