

MISSISSIPPI DEPARTMENT OF NATURAL RESOURCES

Bureau of Land and Water Resources

Southport Mall

P.O. Box 10631

Jackson, Mississippi 39209

WATER WELL DRILLERS LOG

Marshall  
0  
238

Marshall  
 county well located

11-1  
 date well completed

1982  
 HICKS WELL CO.  
 Rt. 1, Box 157  
 Senatobia MS 38660

LANDOWNER:	description of formations encountered	from	to
<u>Longo Wilkins</u>	<u>Red Clay</u>	<u>0</u>	<u>20</u>
<u>Rt. 3 Mariana Rd</u>	<u>Red sand</u>	<u>20</u>	<u>50</u>
<u>Holly Springs, Ms.</u> (mailing address)	<u>White Sand &amp; Clay</u>	<u>50</u>	<u>80</u>
WELL LOCATION: sec. <u>17</u> T. <u>4</u> N. R. <u>3</u> E <u>3 1/2</u> miles <u>E</u> of <u>Mariana</u> (distance) (direction) (nearest town)	<u>White sand</u>	<u>80</u>	<u>155</u>
WELL PURPOSE: <u>Home</u> (home, irrigation, municipal, industrial)	<u>White Sand &amp; Clay</u>	<u>155</u>	<u>160</u>
WELL COMPLETION DATA: (1) diameter (inches) <u>4</u>	<u>White sand</u>	<u>160</u>	<u>200</u>
(2) total depth (feet) <u>200</u>			
(3) static water level (feet) <u>80</u> <u>below</u> top of ground.			
(4) casing <u>PVC</u> <u>200</u> (material) (depth)			
<u>4"</u> (size) if telescope see back.			
(5) screen <u>10</u> <u>190</u> (length) (depth to top)			
<u>0/3</u> <u>PVC</u> (size) (material)			
(6) pump <u>1/2</u> <u>10</u> (HP) (yield gpm)			
<u>220V</u> (type power)			
(7) electric log <u>No</u> (yes or no)			
(organization running log)			
(8) how well bottom plugged <u>CAP</u>			
DRILLERS REMARKS:			


DEPT. OF NATURAL RESOURCES  
 BUREAU OF LAND & WATER RESOURCES

DEC - 8 1982

RECEIVED

If well telescopes please sketch and show depths.

GROUND LEVEL

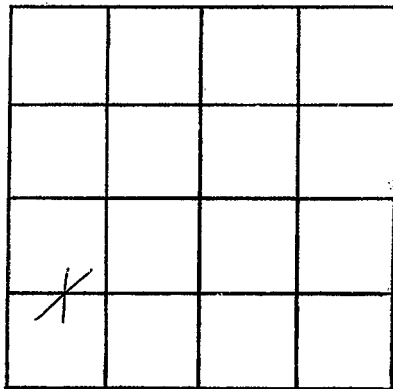

SECTION 17

Please indicate well location X.

ADDITIONAL INFORMATION

If more than one screen, show locations of each on sketch.