

MISSISSIPPI DEPARTMENT OF NATURAL RESOURCES

Bureau of Land and Water Resources

Southport Mall

P.O. Box 10631

Jackson, Mississippi 39209

WATER WELL DRILLERS LOG

Marshall
0
2040

7/8/84 19 Sullitt Well Drilling Marshall
 date well completed firm name county well located

LANDOWNER: Southern Jordan
 (mailing address)

WELL LOCATION:
 sec. 4 T 4 N R 13 E
3 miles West of Hollis
 (distance) (direction) (nearest town)

WELL PURPOSE:
 (home, irrigation, municipal, industrial)

WELL COMPLETION DATA:

(1) diameter (inches) 4"
 (2) total depth (feet) 150'
 (3) static water level (feet) 120' below above top of ground.
 (4) casing PVC, 140
 (material) (depth)
 (size) if telescope see back.
 (5) screen 10', 140
 (length) (depth to top)
4, PVC
 (size) (material)
 (6) pump 1, 18
 (HP) (yield gpm)
Elect
 (type power)
 (7) electric log no
 (yes or no)
 (organization running log)
 (8) how well bottom plugged plugg

description of formations encountered	from	to
<u>top soil</u>	<u>0</u>	<u>2'</u>
<u>red clay</u>	<u>2</u>	<u>20</u>
<u>sand and clay</u>	<u>20</u>	<u>80</u>
<u>white sand</u>	<u>80</u>	<u>150</u>


DEPT. OF NATURAL RESOURCES
 BUREAU OF LAND & WATER RESOURCES

AUG 2 1984
 RECEIVED

DRILLERS REMARKS:

If well telescopes please sketch and show depths.

GROUND LEVEL

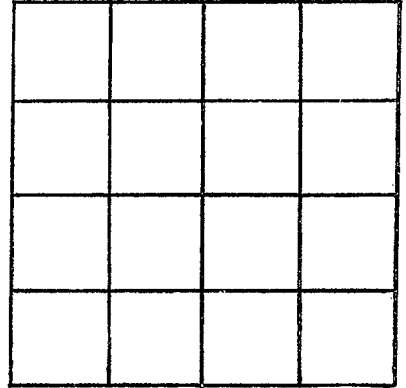

SECTION _____

Please indicate well location X.

ADDITIONAL INFORMATION

If more than one screen,
show locations of each on sketch.