

MISSISSIPPI DEPARTMENT OF NATURAL RESOURCES

Bureau of Land and Water Resources

Southport Mall

P.O. Box 10631

Jackson, Mississippi 39209

WATER WELL DRILLERS LOG

Marshall
 2042

7-2-1986 Hullett Water Well, Marshall
 date well completed firm name county well located

LANDOWNER	description of formations encountered	from, to
<u>Charles H Colonna</u>	<u>Top soil</u>	<u>0' 5'</u>
<u>RT 5 Box 49B</u>	<u>Red clay</u>	<u>5' 15'</u>
<u>Holly Springs, Mo</u> (mailing address)	<u>Red sand & clay</u>	<u>15' 70'</u>
WELL LOCATION:	<u>White sand & clay</u>	<u>70' 180'</u>
sec. <u>14</u> T <u>4</u> N R <u>3</u> E	<u>White sand</u>	<u>180' 205'</u>
<u>6</u> miles <u>East</u> of <u>Holly Springs</u> (distance) (direction) (nearest town)		
WELL PURPOSE: <u>None</u> (home, irrigation, municipal, industrial)		
WELL COMPLETION DATA:		
(1) diameter (inches) <u>4"</u>		
(2) total depth (feet) <u>205</u>		
(3) static water level (feet) <u>140'</u> <u>below</u> top of ground.		
(4) casing <u>4"</u> (material) <u>PVC</u> (depth) <u>195'</u>		
<u>4"</u> (size) If telescope see back.		
(5) screen <u>10'</u> (length) <u>195'</u> (depth to top)		
<u>4"</u> (size) <u>PVC</u> (material)		
(6) pump <u>3/4</u> (HP) <u>10</u> (yield gpm)		
<u>Elec</u> (type power)		
(7) electric log <u>No</u> (yes or no)		
(organization running log)		
(8) how well bottom plugged <u>Cap</u>		


MISSISSIPPI DEPARTMENT OF NATURAL RESOURCES
 BUREAU OF LAND AND WATER RESOURCES
 AUG 11 1986

Department of Natural Resources
 Bureau of Land & Water Resources

DRILLERS REMARKS:

If well telescopes please sketch and show depths.

GROUND LEVEL

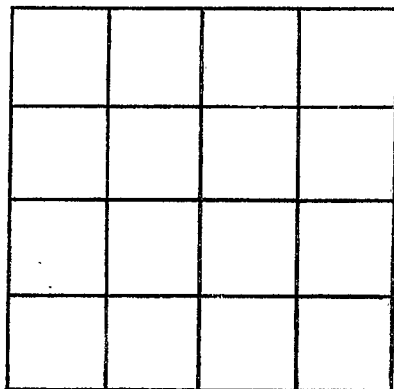

SECTION _____

Please indicate well location X.

ADDITIONAL INFORMATION

If more than one screen,
show locations of each on sketch.