

**MISSISSIPPI DEPARTMENT OF NATURAL RESOURCES**

Bureau of Land and Water Resources

P.O. Box 10631

Jackson, Mississippi 39209

**WATER WELL DRILLERS LOG**

COUNTY WELL LOCATED <i>Marshall</i>	
WELL NUMBER <i>Φ 2047</i>	CODED
DATE WELL COMPLETED <i>9-1-88</i>	

PERMIT NUMBER
<i>HICKS WELL COMPANY</i>
NAME OF DRILLING FIRM
<i>RT. 1 - BOX 15Z</i>
<i>SENATOBIA, MISS.</i>

NAME & MAILING ADDRESS OF LANDOWNER			
<i>Quail Wood Hunting Club</i>			
<i>P.O. Box 1296</i>			
<i>Oxford, Mo. 38655</i>			
WELL LOCATION:	SEC	TOWNSHIP	RANGE
	<i>20</i>	<i>4 N</i>	<i>3 E</i>
DISTANCE	DIRECTION		NEAREST TOWN
<i>3</i> Miles	<i>E</i>		<i>Manassa</i>
OTHER LANDMARK			
WELL PURPOSE <input checked="" type="checkbox"/> Home Irrigation, <input type="checkbox"/> Municipal, <input type="checkbox"/> Industrial, <input type="checkbox"/> Fish Pond, etc.			

PUMP DATA		
PUMP TYPE (Circle One): <input checked="" type="checkbox"/> <del>Submersible</del> , <input type="checkbox"/> Turbine, <input type="checkbox"/> Jet <input type="checkbox"/> Flowing Well, Other (Describe) _____		
POWER TYPE (Circle One): <input checked="" type="checkbox"/> Electric, <input type="checkbox"/> Tractor, <input type="checkbox"/> Diesel, <input type="checkbox"/> Gasoline, <input type="checkbox"/> Butane, Other (Describe) _____		
Pump Capacity (GPM)	No. of Stages	Setting Depth
<i>30</i>	<i>28</i>	<i>200</i> FT.
PUMP TEST		
Well yielded _____ GPM with a drawdown of _____ ft. after _____ hours of pumping		

WELL DATA		
Well Depth <i>240</i>	Casing Diameter (In.) <i>4</i>	Casing Length (Ft.) <i>220</i>
Type of Casing <i>PVC</i>	Hole Depth <i>240</i>	Depth to Static Water Level <i>170</i>
TYPE OF COMPLETION: (Circle One or More): <input checked="" type="checkbox"/> Gravel Packed, <input type="checkbox"/> Underreamed, <input type="checkbox"/> Telescoped, <input checked="" type="checkbox"/> Natural Development, <input type="checkbox"/> Open Hole, <input type="checkbox"/> Other _____		
Top of Lap Pipe or Reduction in Casing		
FEET <input type="checkbox"/> IF TELESCOPED OR MORE THAN ONE SCREEN: USE BACK PAGE		

LOG DATA	
TYPE OF LOG RUN (Circle One): <input checked="" type="checkbox"/> <del>No Log Run</del> , <input type="checkbox"/> Electric, <input type="checkbox"/> Gamma Ray, <input type="checkbox"/> Density, <input type="checkbox"/> Sonic, <input type="checkbox"/> Neutron, Other (Describe) _____	
Name of Organization Running Log	

SCREEN DATA		
Diameter - Inches <i>4</i>	Length - Feet <i>20</i>	Slot Size - Inches <i>1013</i>
Screen Type <i>PVC</i>	Depth to Bottom - Feet <i>0</i>	

GEOLOGIC DATA (Office Use Only)			
Surface Elev.	Geologic Unit	Unit Thickness	Depth to Top
Subs. SWL	Date	Analysis	Aquifer Test
Driller's Remarks			
<b>RECEIVED</b>			

DESCRIPTION OF FORMATIONS ENCOUNTERED	FROM	TO	FORMATIONS (Continued)	
			FROM	TO
<i>Red Clay Sand</i>	<i>0</i>	<i>40</i>		
<i>White Sand</i>	<i>40</i>	<i>240</i>		


**SEP 14 1988**

Department of Natural Resources  
Bureau of Land & Water Resources

IF MORE SPACE IS NEEDED, USE BACK

If well telescopes please  
sketch and show depths.

GROUND LEVEL

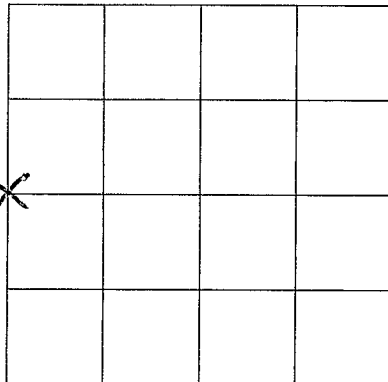

SECTION 20

Please indicate well location X.

ADDITIONAL INFORMATION

Lined area for additional information.

If more than one screen,  
show location of each on sketch.