

1st Well

MISSISSIPPI BOARD OF WATER COMMISSIONERS 416 North State Street Jackson, Mississippi 39201

WATER WELL DRILLERS LOG

MASTRA 2053

1991 Frost Well Co. date well completed firm name county well located

LANDOWNER: Baldwin Beard Organ - P.O. Box 1079 Greenwood, ms (mailing address)

WELL LOCATION: sec. 4 T. 4 N R. 3 E 1/2 miles North of Holly Springs (distance) (direction) (nearest town)

WELL PURPOSE: (home, irrigation, municipal, industrial)

WELL COMPLETION DATA:

- (1) diameter (inches) 4"
(2) total depth (feet) 127'
(3) static water level (feet) 112 below top of ground.
(4) casing PVC, 127 (material) (depth)
(5) screen 10' (length), 117 (depth to top) 4" (size), PVC (material)
(6) pump none (HP), 5 gal per min (yield gpm)
(7) electric log no (yes or no)
(8) how well bottom plugged PVC cap

Table with 3 columns: description of formations encountered, from, to. Rows include clay & sand, coarse yellow sand, clay (white), white clay, gray clay, clay, Rock, Clay, Rock, sand, sand, sand, sand, sand.


RECEIVED MAR 06 1991

Dept. of Environmental Quality Bureau of Land & Water Resources

DRILLERS REMARKS:

If well telescopes please
sketch and show depths.

GROUND LEVEL

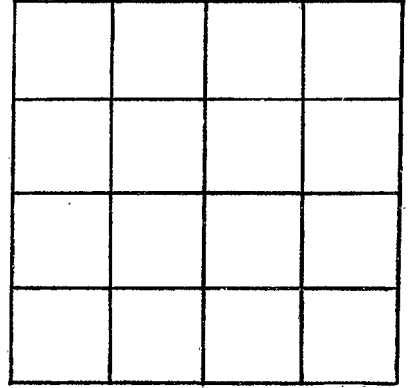

SECTION _____

Please indicate well location X.

ADDITIONAL INFORMATION

If more than one screen,
show locations of each on sketch.