

MISSISSIPPI
 BOARD OF WATER COMMISSIONERS
 416 North State Street
 Jackson, Mississippi 39201

2nd well

WATER WELL DRILLERS LOG

M. A. Smith
 Ⓞ 2054

1-8-91 19 Frost Well Co. county well located

LANDOWNER: *Baldwin Piano*
Organ - P.O. Box 1079
Greenwood ms. 38930
 (mailing address)

WELL LOCATION:
 sec. 4 TL N R. 3 E
 ⑤ north of Holly Springs
 (distance) (direction) (nearest town)

WELL PURPOSE:
 (home, irrigation, municipal, industrial)

WELL COMPLETION DATA:
 (1) diameter (inches) .4"
 (2) total depth (feet) 140
 (3) static water level (feet) 112' below above top of ground.
 (4) casing PVC 140'
 (material) (depth)
 (size) if telescope see back.
 (5) screen 20' 120'
 (length) (depth to top)
4" PVC
 (size) (material)
 (6) pump none 15 gpm
 (HP) (yield gpm)
 (type power)
 (7) electric log no
 (yes or no)
 (organization running log)
 (8) how well bottom plugged PVC
cap

description of formations encountered	from	to
clay	0	5
clay	5	10
clay	10	15
Rock	15	20
sand + clay, mix	20	30
clay	30	40
sand	40	50
sand	50	90
sand	90	140


RECEIVED
 MAR 06 1991

Dept. of Environmental Quality
 Bureau of Land & Water Resources

DRILLERS REMARKS:

If well telescopes please sketch and show depths.

GROUND LEVEL

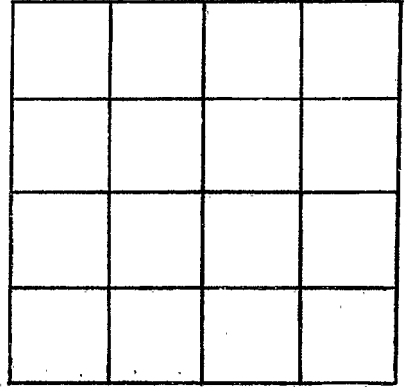

SECTION _____

Please indicate well location X.

ADDITIONAL INFORMATION

If more than one screen,
show locations of each on sketch.