

MISSISSIPPI DEPARTMENT OF ENVIRONMENTAL QUALITY
Bureau of Land and Water Resources

P. O. Box 10631
Jackson, MS 39289-0631
WATER WELL DRILLERS LOG

COUNTY WELL LOCATED
Marshall

WELL NUMBER 2057 CODED

DATE WELL COMPLETED
2-27-91

PERMIT NUMBER
HICKS WELL CO.

NAME OF DRILLING FIRM
RT. 1 BOX 157

SENATOBIA, MS 38668

NAME & MAILING ADDRESS OF LANDOWNER
Saddle Club

RT. 5

Holly Springs, MS

WELL LOCATION: SEC 04 TOWNSHIP 4^N RANGE 3^E W

DISTANCE 2 Miles DIRECTION S/W of NEAREST TOWN H.S.

OTHER LANDMARK

WELL PURPOSE: Home, Irrigation, Municipal, Industrial, Fish Pond, etc.

PUMP DATA

PUMP TYPE (Circle One):
Submersible, Turbine, Jet, Flowing Well,
Other (Describe)

POWER TYPE (Circle One):
Electric, Tractor, Diesel, Gasoline, Butane,
Other (Describe) H/P 1/2

Pump Capacity (GPM)	No. of Stages	Setting Depth
<u>18</u>	<u>18</u>	<u>220</u> FT.

PUMP TEST

Well yielded 18 GPM with
a drawdown of _____ ft.
after _____ hours of pumping

WELL DATA

Well Depth <u>260</u>	Casing Diameter (In.) <u>4"</u>	Casing Length (Ft.) <u>245</u>
Type of Casing <u>PVC</u>	Hole Depth <u>260</u>	Depth to Static Water Level <u>190</u>

TYPE OF COMPLETION: (Circle One or More):
Gravel Packed, Underreamed, Telescoped,
Natural Development, Open Hole, Other

Top of Lap Pipe or Reduction in Casing

FEET IF TELESCOPED OR MORE THAN ONE SCREEN: USE BACK PAGE

LOG DATA

TYPE OF LOG RUN (Circle One):
No Log Run, Electric, Gamma Ray, Density, Sonic, Neutron,
Other (Describe)

Name of Organization Running Log

SCREEN DATA

Diameter - Inches <u>4"</u>	Length - Feet <u>15'</u>	Slot Size - Inches <u>013</u>
Screen Type <u>PVC</u>	Depth to Bottom - Feet <u>260</u>	

GEOLOGIC DATA (Office Use Only)

Surface Elev.	Geologic Unit	Unit Thickness	Depth to Top
Subs. SWL	Date	Analysis	Aquifer Test

Driller's Remarks

DESCRIPTION OF FORMATIONS ENCOUNTERED	FROM	TO
<u>RC</u>	<u>0</u>	<u>15</u>
<u>RC & S</u>	<u>15</u>	<u>90</u>
<u>WS & C</u>	<u>90</u>	<u>200</u>
<u>WS</u>	<u>200</u>	<u>260</u>

FORMATIONS (Continued)	FROM	TO

RECEIVED


APR 12 1991

Dept. of Environmental Quality
Bureau of Land & Water Resources

IF MORE SPACE IS NEEDED, USE BACK

If well telescopes please
sketch and show depths.

GROUND LEVEL

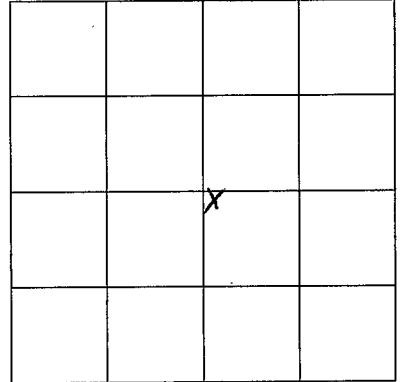

SECTION _____

Please indicate well location X.

ADDITIONAL INFORMATION

If more than one screen,
show location of each on sketch.