

MISSISSIPPI DEPARTMENT OF ENVIRONMENTAL QUALITY
Bureau of Land and Water Resources

P. O. Box 10631
Jackson, MS 39289-0631
WATER WELL DRILLERS LOG

COUNTY WELL LOCATED Marshall	
WELL NUMBER 2065	CODED
DATE WELL COMPLETED 11-22-93	

PERMIT NUMBER HICKS WELL CO.
NAME OF DRILLING FIRM BOX 157 SENATORIA, MS 38668

NAME & MAILING ADDRESS OF LANDOWNER Walker Fitch		
PO 735		
Holly Springs MS 38635		
WELL LOCATION: SEC	TOWNSHIP	RANGE
33	4 N	3 E
DISTANCE	DIRECTION	NEAREST TOWN
3 Miles	West of	Holly Springs
OTHER LANDMARK		
WELL PURPOSE: <input checked="" type="checkbox"/> Home Irrigation, <input type="checkbox"/> Municipal, <input type="checkbox"/> Industrial, <input type="checkbox"/> Fish Pond, etc.		

PUMP DATA		
PUMP TYPE (Circle One): <input checked="" type="checkbox"/> Submersible, <input type="checkbox"/> Turbine, <input type="checkbox"/> Jet, <input type="checkbox"/> Flowing Well, Other (Describe) _____		
POWER TYPE (Circle One): <input checked="" type="checkbox"/> Electric, <input type="checkbox"/> Tractor, <input type="checkbox"/> Diesel, <input type="checkbox"/> Gasoline, <input type="checkbox"/> Butane, Other (Describe) _____ H/P 3/4		
Pump Capacity (GPM) 10	No. of Stages	Setting Depth 180 FT.
PUMP TEST		
Well yielded _____ GPM with a drawdown of _____ ft. after _____ hours of pumping		

WELL DATA		
Well Depth 200'	Casing Diameter (In.) 4"	Casing Length (Ft.) 190'
Type of Casing PVC	Hole Depth 200'	Depth to Static Water Level 160'
TYPE OF COMPLETION: (Circle One or More): <input checked="" type="checkbox"/> Gravel Packed, <input type="checkbox"/> Underreamed, <input type="checkbox"/> Telescoped, <input type="checkbox"/> Natural Development, <input type="checkbox"/> Open Hole, <input type="checkbox"/> Other (Describe) _____		
Top of Lap Pipe or Reduction in Casing FEET IF TELESCOPED OR MORE THAN ONE SCREEN: USE BACK PAGE		

LOG DATA	
TYPE OF LOG RUN (Circle One): <input type="checkbox"/> No Log Run, <input type="checkbox"/> Electric, <input type="checkbox"/> Gamma Ray, <input type="checkbox"/> Density, <input type="checkbox"/> Sonic, <input type="checkbox"/> Neutron, Other (Describe) _____	
Name of Organization Running Log	

SCREEN DATA		
Diameter - Inches 4"	Length - Feet 10'	Slot Size - Inches 13'
Screen Type PVC	Depth to Bottom - Feet 200'	


GEOLOGIC DATA (Office Use Only)			
Surface Elev.	Geologic Unit	Unit Thickness	Depth to Top
Subs. SWL	Date	Analysis	Aquifer Test
Driller's Remarks			

DESCRIPTION OF FORMATIONS ENCOUNTERED	FROM	TO
Sand & Clay	0	120
Clay	120	160
White Sand	160	200

FORMATIONS (Continued)	FROM	TO
RECEIVED		
DEC 21 1993		
Dept. of Environmental Quality Office of Land & Water Resources		
IF MORE SPACE IS NEEDED, USE BACK		

If well telescopes please
sketch and show depths.

GROUND LEVEL

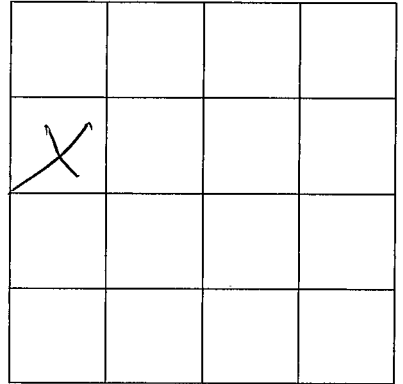

SECTION 33

Please indicate well location X.

ADDITIONAL INFORMATION

If more than one screen,
show location of each on sketch.