

MISSISSIPPI DEPARTMENT OF ENVIRONMENTAL QUALITY

Office of Land and Water Resources

P. O. Box 10631
Jackson, MS 39289-0631
WATER WELL DRILLERS LOG

COUNTY WELL LOCATED Marshall	
WELL NUMBER 2066	CODED
DATE WELL COMPLETED 3-29-99	

PERMIT NUMBER
NAME OF DRILLING FIRM HICKS WELL CO.

NAME & MAILING ADDRESS OF LANDOWNER Cheri Porter		
504 YARBOROUGH Chapel Rd		
Holly Springs, MS 38635		
WELL LOCATION: SEC	TOWNSHIP	RANGE
32	4	3
DISTANCE	DIRECTION	NEAREST TOWN
2 Miles	N	GALENA
OTHER LANDMARK		
WELL PURPOSE: Home, Irrigation, Municipal, Industrial, Fish Pond, etc.		

3			PUMP DATA		
PUMP TYPE (Circle One): Submersible , Turbine, Jet, Flowing Well, Other (Describe) _____					
POWER TYPE (Circle One): Electric, Tractor, Diesel, Gasoline, Butane , Other (Describe) _____ H/P 3/4					
Pump Capacity (GPM)	No. of Stages	Setting Depth			
10		180 FT.			
PUMP TEST					
Well yielded _____ GPM with a drawdown of Test ft. after _____ hours of pumping					

WELL DATA		
Well Depth 230	Casing Diameter (In.) 4	Casing Length (Ft.) 220
Type of Casing PVC	Hole Depth 230	Depth to Static Water Level 150

LOG DATA	
TYPE OF LOG RUN (Circle One): No Log Run , Electric, Gamma Ray, Density, Sonic, Neutron, Other (Describe) _____	
Name of Organization Running Log	

TYPE OF COMPLETION: (Circle One or More): Gravel Packed , Underreamed, Telescoped, Natural Development, Open Hole, Other	
WELL GROUTED TO A DEPTH OF 3 FEET Type Grout (circle one) Cement , Bentonite, or Mix	

GEOLOGIC DATA (Office Use Only)			
Surface Elev.	Geologic Unit	Unit Thickness	Depth to Top
Subs. SWL	Date	Analysis	Aquifer Test
Driller's Remarks			
Top of Lap Pipe or Reduction in Casing			
FEET		IF TELESCOPED OR MORE THAN ONE SCREEN: USE BACK PAGE	


SCREEN DATA		
Diameter - Inches 4	Length - Feet 10'	Slot Size - Inches .014
Screen Type PVC Slot	Depth to Bottom - Feet 220	

DESCRIPTION OF FORMATIONS ENCOUNTERED	FROM	TO
Red Clay	0	10
Red Sand & Clay	10	30
Red & White Clay & Sand	30	150
White Sand	150	230

FORMATIONS (Continued)	FROM	TO
RECEIVED		
APR 02 1999		
Dept. of Environmental Quality Office of Land & Water Resources		
IF MORE SPACE IS NEEDED, USE BACK		

If well telescopes please
sketch and show depths.

GROUND LEVEL

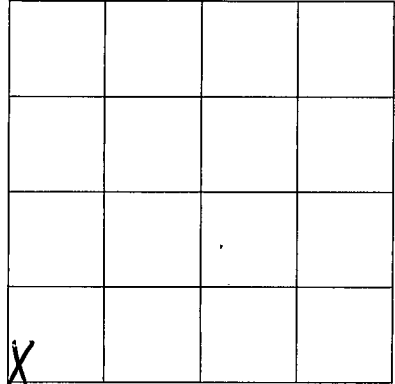

SECTION 32

Please indicate well location X.

ADDITIONAL INFORMATION

If more than one screen,
show location of each on sketch.