

**MARSHALL**  
 P  
 4-6-76

MISSISSIPPI  
 BOARD OF WATER COMMISSIONERS  
 416 North State Street  
 Jackson, Mississippi 39201

WATER WELL DRILLERS LOG


4-6 1976 Hicks Well Co. Marshall  
 date well completed firm name county well located

LANDOWNER: <u>JAMES SMITH</u> <u>Rt. 2</u>	description of formations encountered	from	to
<u>Potts Camp, Miss.</u> (mailing address)	<u>RED CLAY</u> <u>RED SAND</u> <u>WHITE SAND</u>	<u>0</u> <u>10</u> <u>40</u>	<u>10</u> <u>20</u> <u>155</u>
<b>WELL LOCATION:</b> sec. <u>26</u> T. <u>4</u> N. R. <u>2</u> E. <u>2</u> miles <u>N</u> of <u>LAKE CENTER</u> (distance) (direction) (nearest town)			
<b>WELL PURPOSE:</b> <u>HOME</u> (home, irrigation, municipal, industrial)			
<b>WELL COMPLETION DATA:</b>			
(1) diameter (inches) <u>4"</u>			
(2) total depth (feet) <u>155</u>			
(3) static water level (feet) <u>90</u> below above top of ground.			
(4) casing <u>PVC</u> , <u>148</u> (material) (depth)			
(size) if telescope see back.			
(5) screen <u>7'</u> , <u>7'</u> (length) (depth to top)			
<u>4"</u> , <u>INSIDE GRAVEL</u> (size) (material)			
(6) pump <u>1/2</u> <u>10</u> (HP) (yield gpm)			
<u>220</u> (type power)			
(7) electric log <u>NO</u> (yes or no)			
(organization running log)			
(8) how well bottom plugged <u>CMP</u>			
<b>DRILLERS REMARKS:</b>			

MAY 9 1976  
 MISS. Bd. of WATER COMMISSIONERS

If well telescopes please sketch and show depths.

GROUND LEVEL

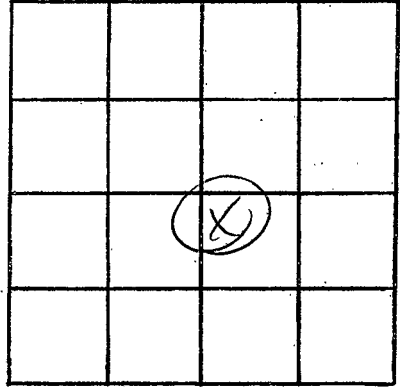

SECTION \_\_\_\_\_

Please indicate well location X.

ADDITIONAL INFORMATION

If more than one screen, show locations of each on sketch.