

MARSHALL
P
7-13-77

MISSISSIPPI
 BOARD OF WATER COMMISSIONERS
 416 North State Street
 Jackson, Mississippi 39201

WATER WELL DRILLERS LOG

7-13-77 ^{15F} **Hicks well co** **Marshall**
 date well completed firm name county well located

LANDOWNER: **J. V. Murdock**
RR-1, Holly Springs
 (mailing address)

description of formations encountered	from	to
Red clay	0	40
Red sand	40	80
White clay	80	140
White sand	140	260

WELL LOCATION:
 sec. 12 T. 4 N. R. 2 E.
 (distance) (direction) (nearest town)
4 miles SE of Holly Springs

WELL PURPOSE: Domestic
 (home, irrigation, municipal, industrial)

- WELL COMPLETION DATA:
- (1) diameter (inches) 4"
 - (2) total depth (feet) 260
 - (3) static water level (feet) 125 below above top of ground.
 - (4) casing PVC, 253,
 (material) (depth)
 (size) If telescope see back.
 - (5) screen 7', 7'
 (length) (depth to top)
4, inside pack
 (size) (material)
 - (6) pump 3/4, 10
 (HP) (yield gpm)
Elec
 (type power)
 - (7) electric log Co
 (yes or no)
 - (organization running log)
 - (8) how well bottom plugged Cap


DRILLERS REMARKS:

RECEIVED
 AUG 19 1977

MISS. BD. OF WATER COMM.

If well telescopes please
sketch and show depths.

GROUND LEVEL

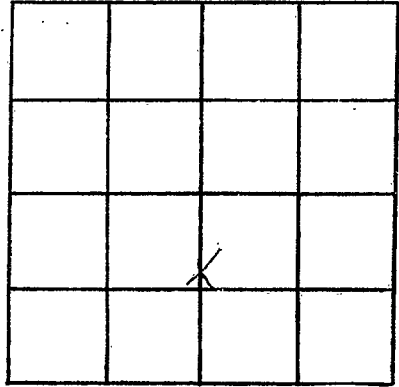

SECTION _____

Please indicate well location X.

ADDITIONAL INFORMATION

If more than one screen,
show locations of each on sketch.