

MARSHALL

Q P

3-16-78

MISSISSIPPI BOARD OF WATER COMMISSIONERS  
416 North State Street  
Jackson, Mississippi 39201

WATER WELL DRILLERS LOG

3-16 1978 Hicks Well Co Marshall  
date well completed firm name county well located

LANDOWNER: Crestone Faulkner

Description of formations encountered

from to

Rt. 3, Box 545  
Holly Springs, Ms  
(mailing address)

Red Clay 0 40

Red Sand + Clay 40 180

WELL LOCATION:

sec. 34 T. 4 N. R. 3 E.  
2 1/2 miles S.E. of Holly Springs  
(distance) (direction) (nearest town)

White Sand 180 233

WELL PURPOSE: stone  
(home, irrigation, municipal, industrial)

WELL COMPLETION DATA:

(1) diameter (inches) 4

(2) total depth (feet) 233

(3) static water level (feet) 213 below above top of ground.

(4) casing PVC 233  
(material) (depth)

(size) if telescope see back.

(5) screen 7" 226  
(length) (depth to top)

4" gravel type  
(size) (material)

(6) pump 3/4 10  
(HP) (yield gpm)

220W  
(type power)

(7) electric log No.  
(yes or no)

(organization running log)

(8) how well bottom plugged cap


DRILLERS REMARKS:

RECEIVED  
MAY 1 - 1978

MISS. BO. OF WATER COMM.

If well telescopes please sketch and show depths.

GROUND LEVEL

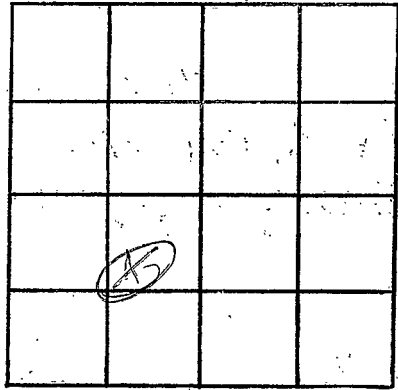

SECTION 34

Please indicate well location X.

ADDITIONAL INFORMATION

If more than one screen, show locations of each on sketch.