

15F

CODED

Marshall
P 11
6-10-68

MISSISSIPPI
BOARD OF WATER COMMISSIONERS
416 North State Street
Jackson, Mississippi 39201

CODED

WATER WELL DRILLERS LOG

June 10 1968 R. L. Carpenter Marshall
date well completed firm name county well located

LANDOWNER: V. D. Moore
Holy Springs
Miss
(mailing address)

| description of formations encountered | from | to |
|---------------------------------------|------|-----|
| Surface Soil | 0 | 17 |
| Med Red Soil | 17 | 65 |
| Coarse White Sand | 65 | 78 |
| White Clay | 78 | 87 |
| White Fine Sand | 87 | 120 |
| Coarse White Sand | 120 | 145 |

WELL LOCATION:
sec. 8 T. 4 N. R. 2 E
One miles ^{South} of Holy Springs
(distance) (direction) (nearest town)

WELL PURPOSE: Home
(home, irrigation, municipal, industrial)

WELL COMPLETION DATA:

- (1) diameter (inches) 4 in.
- (2) total depth (feet) 145
- (3) static water level (feet) 120 below above top of ground.
- (4) casing Plastic, 139 Ft.
(material) (depth)
- _____ if telescope see back.
(size)
- (5) screen 6 Ft., 139 Ft.
(length) (depth to top)
- 4 in., Plastic Thread
(size) (material)
- (6) pump 3/4 HP, 10
(HP) (yield gpm)
- Elec.
(type power)
- (7) electric log No
(yes or no)
- _____ (organization running log)
- (8) how well bottom plugged Plastic Plug

CODED

JAN 29 1969

MISS. BD. OF
WATER COM.


DRILLERS REMARKS:

If well telescopes please sketch and show depths.

GROUND LEVEL

R 2 W

T 4 S

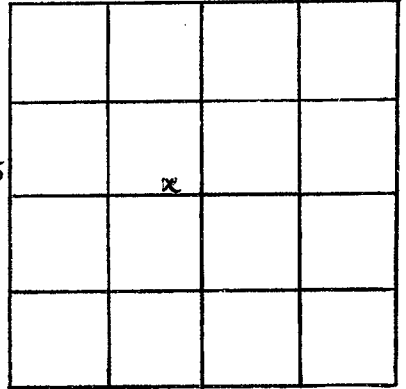

SECTION 8

Please indicate well location X.

ADDITIONAL INFORMATION

If more than one screen, show locations of each on sketch.