

15 F

CODED

CODED

Marshall  
P 12  
6-15-68

MISSISSIPPI  
BOARD OF WATER COMMISSIONERS  
416 North State Street  
Jackson, Mississippi 39201

WATER WELL DRILLERS LOG

June 15 1968 R. L. Carpenter Marshall  
date well completed firm name county well located

LANDOWNER: Oason Mc Dowen  
Holly Springs  
Miss  
(mailing address)

Description of formations encountered	from	to
Surface Soil	0	21
Med Red Sand	21	49
Med. white sand	49	80
White Clay	80	92
Med & fine white sand	92	130
Coarse white sand	130	165

WELL LOCATION:  
sec. 8 T. 4 N. R. 2 E.  
5 South W  
0.5 miles of Holly Springs  
(distance) (direction) (nearest town)

WELL PURPOSE: Home  
(home, irrigation, municipal, industrial)

- WELL COMPLETION DATA:
- (1) diameter (inches) 4 in.
  - (2) total depth (feet) 165
  - (3) static water level (feet) 105 below top of ground.
  - (4) casing Plastic, 159 ft. (material) (depth)
  - (size) If telescope see back.
  - (5) screen 6 ft., 159 ft. (length) (depth to top)
  - 4 in., Plastic & gravel (size) (material)
  - (6) pump 3/4 HP, 12 (HP) (yield gpm)
  - Elec. (type power)
  - (7) electric log No (yes or no)
  - (organization running log) Plastic Plug
  - (8) how well bottom plugged

CODED

JAN 23 1969

DRILLERS REMARKS:


MISS. BD. OF  
WATER COMM.

If well telescopes please sketch and show depths.

R = W

GROUND LEVEL

f 45

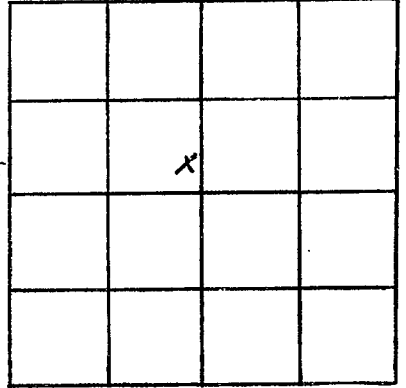

SECTION S

Please indicate well location X.

ADDITIONAL INFORMATION

If more than one screen, show locations of each on sketch.