

15 F

CODED

Marshall
P13
8-7-68

MISSISSIPPI
BOARD OF WATER COMMISSIONERS
416 North State Street
Jackson, Mississippi 39201

CODED

WATER WELL DRILLERS LOG

aug. 7 1968 R. L. Casente Marshall
date well completed firm name county well located

LANDOWNER: Mrs. Cas. Tramm

description of formations encountered

from to

Holly Springs, Miss

Surface soil 0 18

Rt. 1

(mailing address)

Med Red sand 18 35

WELL LOCATION:

sec. 35 T. 4 N. R. 2 E
5 1/2 miles Northwest of Potts Camp
(distance) (direction) (nearest town)

White coarse sand 35 70

White clay 70 91

WELL PURPOSE: Home
(home, irrigation, municipal, industrial)

White coarse sand 91 100

WELL COMPLETION DATA:

White fine sand & white clay 100 118

(1) diameter (inches) 4 in.

White coarse sand 118 127

(2) total depth (feet) 127 ft.

(3) static water level (feet) 87 below top of ground.

(4) casing Plastic, 121 (material) (depth)

(size) if telescope see back.

(5) screen 6 ft., 121 ft. (length) (depth to top)

4 in., Plastic & gravel (size) (material)

(6) pump 3/4 HP, 12 (yield gpm)

Elex (type power)

(7) electric log No (yes or no)

(organization running log)

(8) how well bottom plugged Plastic plug

CODED

JAN 29 1969

MISS. BD. OF WATER COM.


DRILLERS REMARKS:

If well telescopes please sketch and show depths.

GROUND LEVEL

R 2 W

T 4 S

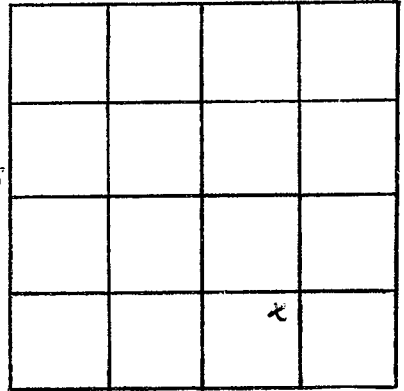

SECTION 35

Please indicate well location X.

ADDITIONAL INFORMATION

If more than one screen, show locations of each on sketch.