

CODED

MARSHALL
P 15
11-10-68

MISSISSIPPI
BOARD OF WATER COMMISSIONERS
416 North State Street
Jackson, Mississippi 39201

CODED

WATER WELL DRILLERS LOG

Nov-10-1968 date well completed
Kempson Well Co firm name
Marshall county well local

LANDOWNER:

James White
Rt#1 Holly Springs Mill
(mailing address)

description of formations encountered

Red Clay
Sand
From To
0 20
90 100

WELL LOCATION:

sec. 28 T 4 N R 2 E
S W
1 miles Mill of Northwest
(distance) (direction) (nearest town)

WELL PURPOSE:

(home, irrigation, municipal, industrial)

WELL COMPLETION DATA:

- (1) diameter (inches) 4"
- (2) total depth (feet) 120
- (3) static water level (feet) 90 below top of ground.
- (4) casing 4" PVC 113 (material) (depth)
- (size) if telescope see back.
- (5) screen 7' 113 (length) (depth to top)
- 4" sand/gravel (size) (material)
- (6) pump 3/4 10 gal (HP) (yield/gpm)
- Label (type power)
- (7) electric log (yes or no)
- (organization running log)
- (8) how well bottom plugged 4" cap

CODED


FEB 17 1969

MISS. BD. OF WATER COMMISSIONERS

DRILLERS REMARKS:

If well telescopes please sketch and show depths.

GROUND LEVEL

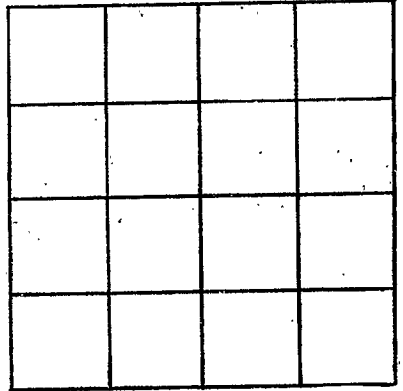

SECTION _____

Please indicate well location X.

ADDITIONAL INFORMATION

If more than one screen, show locations of each on sketch.