

MISSISSIPPI
 BOARD OF WATER COMMISSIONERS
 416 North State Street
 Jackson, Mississippi 39201

CODED

WATER WELL DRILLERS LOG

Marshall
P 18
5-25-70

May 25 1970 R. L. Carpenter Marshall
 date well completed firm name county well located

LANDOWNER: <u>Wenderson Males</u>	description of formations encountered	from	to
<u>Holly Springs, Miss.</u> (mailing address)			
	<u>Surface Sand</u>	<u>0</u>	<u>19</u>
	<u>Coarse Red Sand</u>	<u>19</u>	<u>47</u>
	<u>Med White Sand</u>	<u>47</u>	<u>93</u>
	<u>White Clay</u>	<u>93</u>	<u>188</u>
	<u>Med. White Sand</u>	<u>108</u>	<u>153</u>
	<u>White Coarse Sand</u>	<u>153</u>	<u>180</u>

WELL LOCATION:
 sec. 9 T 4 N R. 2 E
2 miles South of Holly Springs
 (distance) (direction) (nearest town)

WELL PURPOSE: None
 (home, irrigation, municipal, industrial)

WELL COMPLETION DATA:

- (1) diameter (inches) 4
- (2) total depth (feet) 180
- (3) static water level (feet) 140 below above top of ground.
- (4) casing Plastic, 174 ft.
 (material) (depth)
 (size) if telescope see back.
- (5) screen 6 ft., 174 ft.
 (length) (depth to top)
4 in., Plastic Panel
 (size) (material)
- (6) pump 3/4 10
 (HP) (yield gpm)
Elec.
 (type power)
- (7) electric log no
 (yes or no)

(organization running log) Plastic cap
 (8) how well bottom plugged

DRILLERS REMARKS:

CODED


JUL 13 1970

PALES, ENG. INC.

If well telescopes please sketch and show depths.

GROUND LEVEL

R2W

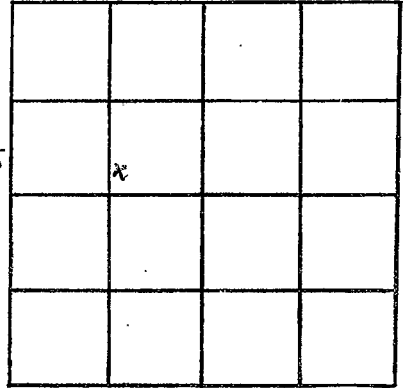

SECTION 9

Please indicate well location X.

ADDITIONAL INFORMATION

If more than one screen, show locations of each on sketch.