

MARSHALL
P 20
3-1-71

MISSISSIPPI
 BOARD OF WATER COMMISSIONERS
 416 North State Street
 Jackson, Mississippi 39201

CODED

WATER WELL DRILLERS LOG

3-1-71 date well completed 19 71 *Sumner Wells* firm name *Marshall* county well located
Holly Springs, Miss.

LANDOWNER:

Henry Lee Walcott
P.O. 2, Potts Camp, Miss.
 (mailing address)

description of formations encountered

from

to

clay	0	10
Sand	10	150

WELL LOCATION:

sec. 25 T. 4 N. R. 2 E.
 7 miles South of N.S.
 (distance) (direction) (nearest town)

WELL PURPOSE:

Dwelling
 (home, irrigation, municipal, industrial)

WELL COMPLETION DATA:

- (1) diameter (inches) 4"
- (2) total depth (feet) 150 feet
- (3) static water level (feet) 10 ft below top of ground.
- (4) casing PVC (material), 150 ft (depth)
 (size) if telescope see back.
- (5) screen 6 ft (length), 144 ft (depth to top)
4" (size), gravel wall (material)
- (6) pump 3/4 (HP), 10 (yield gpm)
 (type power)
- (7) electric log elect (yes or no)
 (organization running log)
- (8) how well bottom plugged 4" cap.

CODED


MAR 2 - 1971

DRILLERS REMARKS:

MISS. DD. 3
 WATER COM.

If well telescopes please
sketch and show depths.

GROUND LEVEL

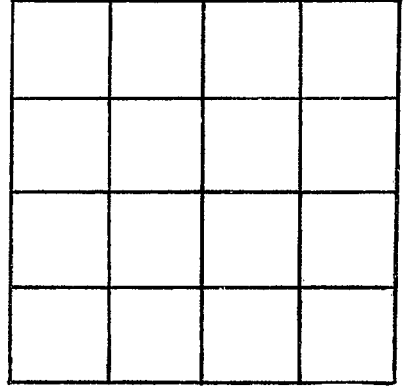

SECTION _____

Please indicate well location X.

ADDITIONAL INFORMATION

If more than one screen,
show locations of each on sketch.