

P21

WATER WELL DRILLERS LOG

CODED

Date: 9-16, 19___, Driller: abco of Independence County Marshall
(Name) Jarvis Bros.

(1) Owner of Land: James Holloway
(Name)
Holly Springs Rte 2
(Address)
5 4 2
(2) Location: 1/4, 1/4, Sec. T R
miles of
(distance) (direction) (Nearest Town)
(3) Topography:
(Hilly) (Flat) (Level)
(4) Purpose of Well:
(Domestic Irrigation
Municipal, Industrial, Other)


Description & Color of Materials Sand, Clay, Red Clay, Shell, etc.	Thick- ness Feet	Depth Feet
top soil	0	15
red sand	15	45
sand + clay strips	45	120
fine sand + clay mixed	120	200
good coarse sand	200	220

Information upon completion of well:

(1) Diameter 4 inches.
(2) Total Depth 220 feet.
(3) Water Level 160 feet below top of ground.
(4) Cased to 206, Size 4"
(5) Screen: Size 4", Length 14'
(6) Were any formations sealed against pollution?
yes, no.

CODED

If YES depth of formation
Why
Drillers Remarks:

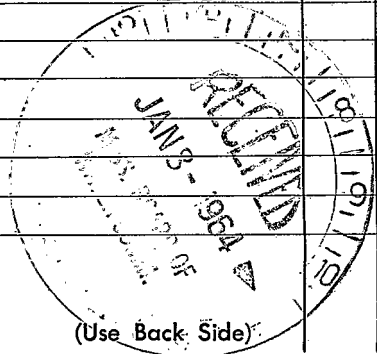

(Use Back Side)

Well No.

