

Marshall
P 29
 9-1-68

MISSISSIPPI
 BOARD OF WATER COMMISSIONERS
 416 North State Street
 Jackson, Mississippi 39201

CODED

WATER WELL DRILLERS LOG

Sept 1 1968 *Pumpco Well Co* *Marshall*
 date well completed firm name county well located

LANDOWNER: *Seraf Mosley*
A # 2 Path Camp, Miss

description of formations encountered	from	to
<i>Clay</i>	<i>0</i>	<i>15</i>
<i>Ssh</i>	<i>15</i>	<i>100</i>

(mailing address)

WELL LOCATION:
 sec. 26 T 4 N R 2 E
 (distance) miles in Whites (direction) (nearest town)

WELL PURPOSE:
 (home, irrigation, municipal, industrial)

WELL COMPLETION DATA:

- (1) diameter (inches) 4'
- (2) total depth (feet) 100
- (3) static water level (feet) 40 below above top of ground.
- (4) casing plastic, 100,
 (material) (depth)
- 2"
 (size) if telescope see back.
- (5) screen 24, 93
 (length) (depth to top)
- 1", over plastic
 (size) (material)
- (6) pump 3/4, 10
 (HP) (yield gpm)

(type power)


(7) electric log _____
 (yes or no)

(organization running log)

(8) how well bottom plugged 4' cap


DRILLERS REMARKS:

CODED

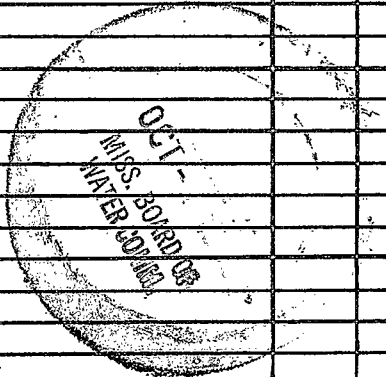

If well telescopes please sketch and show depths.

GROUND LEVEL

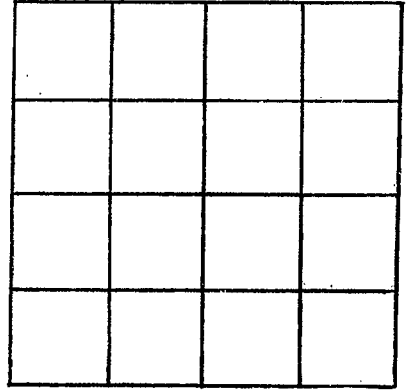

SECTION _____

Please indicate well location X.

ADDITIONAL INFORMATION

If more than one screen, show locations of each on sketch.